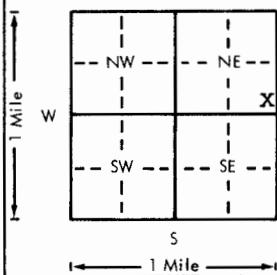
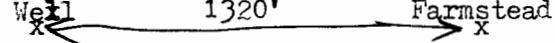


USE TYPEWRITER OR BALL
POINT PEN-PRESS FIRMLY,
PRINT CLEARLY.

WATER WELL RECORD
KSA 82a-1201-1215

Kansas Department of Health and
Environment-Division of Environment
(Water well Contractors)
Topeka, Kansas 66620

1. Location of well:	County	Fraction	Section number	Township number	Range number
	Wichita	SE 1/4 SE 1/4 NE 1/4	7	T 20	S R 35
2. Distance and direction from nearest town or city: <i>10 1/2 miles South of Marietta, Kans</i>			3. Owner of well: Alex Holstein		
Street address of well location if in city:			R.R. or street: City, state, zip code: Leoti, Kansas		
4. Locate with "X" in section below: 			Sketch map: 		
			6. Bore hole dia. 9 in. Completion date _____ Well depth 110 ft. 14/27/79		
			7. <input type="checkbox"/> Cable tool <input checked="" type="checkbox"/> Rotary <input type="checkbox"/> Driven <input type="checkbox"/> Dug <input type="checkbox"/> Hollow rod <input type="checkbox"/> Jetted <input type="checkbox"/> Bored <input type="checkbox"/> Reverse rotary		
			8. Use: <input type="checkbox"/> Domestic <input type="checkbox"/> Public supply <input type="checkbox"/> Industry <input type="checkbox"/> Irrigation <input type="checkbox"/> Air conditioning <input checked="" type="checkbox"/> Stock <input type="checkbox"/> Lawn <input type="checkbox"/> Oil field water <input type="checkbox"/> Other		
			9. Casing: Material <input checked="" type="checkbox"/> Plastic <input type="checkbox"/> Threaded <input type="checkbox"/> Welded <input type="checkbox"/> Surface 12 in. RMP <input checked="" type="checkbox"/> PVC <input type="checkbox"/> Weight 1.8 lbs./ft. Dia. <input checked="" type="checkbox"/> 90 ft. depth Wall Thickness: inches or Dia. in. to ft. depth gage No. 250		
5. Type and color of material			From	To	10. Screen: Manufacturer's name Jess & Lowell
clay			0	22	Type RMP Dia. 5"
sand			22	106	Slot/gauze 1/16 Length 20 Set between 90 ft. and 110 ft.
clay yellow			106	110	ft. and $\frac{1}{4}$ ft. Gravel pack? yes Size range of material $\frac{1}{4}$ x $\frac{1}{8}$
			11. Static water level: 90 ft. below land surface Date 4/24/79		
			12. Pumping level below land surfaces: 94 ft. after 4 hrs. pumping 4 g.p.m. ft. after hrs. pumping g.p.m. Estimated maximum yield g.p.m.		
			13. Water sample submitted: mo./day/yr. Yes <input checked="" type="checkbox"/> No Date		
			14. Well head completion: Pitless adapter 12 Inches above grade		
			15. Well grouted? yes With: <input checked="" type="checkbox"/> Neat cement <input type="checkbox"/> Bentonite <input type="checkbox"/> Concrete Depth: From 0 ft. to 15 ft.		
			16. Nearest source of possible contamination: ft. 1320 Direction East Type Farmstead Well disinfected upon completion? <input checked="" type="checkbox"/> Yes <input type="checkbox"/> No		
			17. Pump: Not installed Manufacturer's name Monitor Model number HP Volts Length of drop pipe 90 ft. capacity 4 g.p.m. Type: <input type="checkbox"/> Submersible <input type="checkbox"/> Turbine <input type="checkbox"/> Jet <input type="checkbox"/> Reciprocating <input type="checkbox"/> Centrifugal cylinder <input type="checkbox"/> Other		
(Use a second sheet if needed)			18. Elevation: Topography: <input type="checkbox"/> Hill <input type="checkbox"/> Slope <input checked="" type="checkbox"/> Upland <input type="checkbox"/> Valley		
			19. Remarks: TOPO 3148		
			20. Water well contractor's certification: This well was drilled under my jurisdiction and this report is true to the best of my knowledge and belief. Weishaar Drilling & Supply 232 Business name Scott City, Kansas 67871 Address Signed <i>Raymond Weishaar</i> Date 5/14/79 Authorized representative		