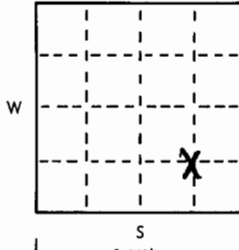
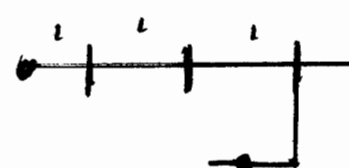


USE TYPEWRITER OR BALL
POINT PEN-PRESS FIRMLY,
PRINT CLEARLY.

WATER WELL RECORD
KSA 82a-1201-1215

T R EW sec 1/4 1/4 1/4 No.

Kansas State Dept. Of Health
(Water Well Contractors)
Forbes-Bldg. 740
Topeka, Kansas 66620

1 Location of well:	County <u>McPherson</u>	Township name <u>Jackson</u>	Section number <u>3</u>	Town number <u>205</u>	Range number <u>4 W</u>
Distance and direction from nearest town or city: <u>3 E of Conway</u> <u>150 1/2 West in field</u>			3 Owner of well: <u>William Schrag</u> Address: <u>R. R. 2 McPherson, Kansas 67460</u>		
Locate with "X" in section below: N  W E S 1 Mile			Sketch map: 		
4 Well depth: <u>220</u> ft. Date of completion <u>8/10/78</u> Well diameter <u>26</u> in.			5 <input type="checkbox"/> Cable tool <input type="checkbox"/> Rotary <input type="checkbox"/> Driven <input type="checkbox"/> Dug <input type="checkbox"/> Hollow rod <input type="checkbox"/> Jetted <input type="checkbox"/> Bored <input checked="" type="checkbox"/> Reverse rotary		
6 Use: <input type="checkbox"/> Domestic <input type="checkbox"/> Public supply <input type="checkbox"/> Industry <input checked="" type="checkbox"/> Irrigation <input type="checkbox"/> Air conditioning <input type="checkbox"/> Commercial <input type="checkbox"/> Test well <input type="checkbox"/>			7 Casing: Material <u>Transite</u> Height: above/below Threading <input type="checkbox"/> Welded <input type="checkbox"/> Surface <u>12</u> in. Diam. <u>16</u> in. to <u>16</u> ft. depth Drive shoe? <input type="checkbox"/> Yes <input checked="" type="checkbox"/> No <u>0</u> in. to <u>16</u> ft. depth		
2 Type and color of material			8 Screen: Manufacturer <u>Johnson</u> Type <u>3/16</u> Dia. <u>16</u> Slot/gauze <u>168</u> Length <u>52</u> Set between <u>168</u> ft. and <u>220</u> ft. Fittings: <u>1/8-1/4</u> Gravel pack <input checked="" type="checkbox"/> Yes <input type="checkbox"/> No Size range of material <u> </u>		
Top soil 0 3			9 Static water level: <u>76</u> ft. below land surface Date <u>8-10-79</u>		
Black Clay 3 5			10 Pumping level below land surfaces: <u>95</u> ft. after <u>1</u> hrs. pumping <u>600</u> g.p.m. <u>108</u> ft. after <u>2</u> hrs. pumping <u>200</u> g.p.m. Estimated maximum yield <u>1300</u> g.p.m.		
Brown clay 5 50			11 Water sample submitted: <input type="checkbox"/> Yes <input checked="" type="checkbox"/> No Date <u> </u>		
Brown clay 50 75			12 Well head completion: <input type="checkbox"/> Pitless adapter <input checked="" type="checkbox"/> Inches above grade		
Fine sand 75 100			13 Well grouted? <input checked="" type="checkbox"/> Yes <input type="checkbox"/> No <input type="checkbox"/> Neat cement <input type="checkbox"/> Bentonite <input checked="" type="checkbox"/> Cement Depth: From <u>0</u> ft. to <u>10</u> ft.		
Fine sand with clay 100 130			14 Nearest source of possible contamination: ft. <u> </u> Direction <u>none</u> Type <u> </u> Well disinfected upon completion? <input type="checkbox"/> Yes <input checked="" type="checkbox"/> No		
Gray sticky clay 130 150			15 Pump: <input type="checkbox"/> Not installed Manufacturer's name <u>Western Land Roller</u> Model number <u>300-100HC 80</u> Volts <u> </u> Length of drop pipe <u>50</u> ft. capacity <u>100</u> g.p.m. Type: <input type="checkbox"/> Submersible <input checked="" type="checkbox"/> Turbine <input type="checkbox"/> Jet <input type="checkbox"/> Reciprocating <input type="checkbox"/> Centrifugal <input type="checkbox"/> Other		
Fine Sand 150 220			16 Remarks: elevation		
Shale 220 223			17 Water well contractor's certification: This well was drilled under my jurisdiction and this report is true to the best of my knowledge and belief. <u>Rosenkrantz-Bemis Ent. Inc.</u> Business name <u>1211 W. 4th, Hutchinson, Kansas</u> License No. <u>106134</u> Address <u>Mike Owens</u> Date <u>9-8-79</u> Signed <u> </u> Authorized representative		
(use a second sheet if needed)					

Forward the white, blue and pink copies to the Kansas State Dept. Of Health.

Form WWC-5