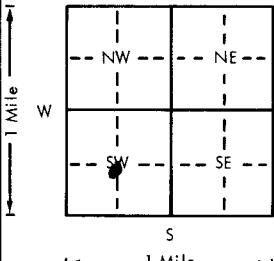
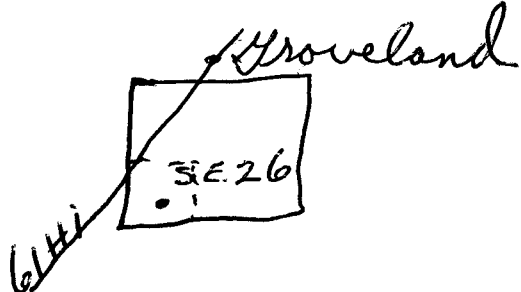


USE TYPEWRITER OR BALL
POINT PEN-PRESS FIRMLY,
PRINT CLEARLY.

WATER WELL RECORD
KSA 82a-1201-1215

Kansas Department of Health and
Environment-Division of Environment
(Water well Contractors)
Topeka, Kansas 66620

1. Location of well:		County McPherson	Fraction X NE 1/4 SW 1/4 SW 1/4	Section number 26	Township number T 20-S	Range number R 41W E/W
2. Distance and direction from nearest town or city: 1 mi. S Groveland			3. Owner of well: Arden Penner R.R. or street: RFD City, state, zip code: Inman, Kansas 67546			
4. Locate with "X" in section below:		Sketch map:		6. Bore hole dia. 26 in. Completion date 6/13/77 Well depth 128 ft.		
				7. <input type="checkbox"/> Cable tool <input type="checkbox"/> Rotary <input type="checkbox"/> Driven <input type="checkbox"/> Dug <input type="checkbox"/> Hollow rod <input type="checkbox"/> Jetted <input type="checkbox"/> Bored <input checked="" type="checkbox"/> Reverse rotary		
5. Type and color of material				8. Use: <input type="checkbox"/> Domestic <input type="checkbox"/> Public supply <input type="checkbox"/> Industry <input checked="" type="checkbox"/> Irrigation <input type="checkbox"/> Air conditioning <input type="checkbox"/> Stock <input type="checkbox"/> Lawn <input type="checkbox"/> Oil field water <input type="checkbox"/> Other		
				9. Casing: Material Transite Height: Above or below Threaded <input type="checkbox"/> Welded <input type="checkbox"/> Surface 18 in. RMP <input type="checkbox"/> PVC <input type="checkbox"/> Weight 30 lbs./ft. Dia. 16 in. to 19 ft. depth Wall Thickness: inches Dia. 16 in. to 19 ft. depth gage No. 305 9/4		
				10. Screen: Manufacturer's name Johnson Type sawed Dia. 128 Slot/gauze 3/16 Length 128 Set between 89 ft. and 128 ft. ft. and 128 ft. Gravel pack? yes Size range of material 1/8-1/2		
				11. Static water level: 28 ft. below land surface Date 6/13/77 mo./day/yr.		
				12. Pumping level below land surfaces: 52 ft. after 1 hrs. pumping 800 g.p.m. 12 ft. after 1200 hrs. pumping 1200 g.p.m. Estimated maximum yield 1500 g.p.m.		
				13. Water sample submitted: X Yes <input type="checkbox"/> No Date 6/13/77 mo./day/yr.		
				14. Well head completion: <input type="checkbox"/> Pitless adapter 12 inches above grade		
				15. Well grouted? yes With: <input type="checkbox"/> Neat cement <input type="checkbox"/> Bentonite <input checked="" type="checkbox"/> Concrete Depth: From 0 ft. to 10 ft.		
				16. Nearest source of possible contamination: ft. 10 Direction SW Type SW Well disinfected upon completion? <input type="checkbox"/> Yes <input checked="" type="checkbox"/> No		
				17. Pump: <input type="checkbox"/> Not installed Manufacturer's name Western Land Roller Model number 145 H HP 1/2 Volts 115 Length of drop pipe 20 ft. capacity 1400 g.p.m. Type: <input type="checkbox"/> Submersible <input checked="" type="checkbox"/> Turbine <input type="checkbox"/> Jet <input type="checkbox"/> Reciprocating <input type="checkbox"/> Centrifugal <input type="checkbox"/> Other		
(Use a second sheet if needed)						
18. Elevation:		19. Remarks:		20. Water well contractor's certification: This well was drilled under my jurisdiction and this report is true to the best of my knowledge and belief. Darling Drilling Co. 189 Business name License No. 1271 W. 4th Hutchinson, Ks. Address Donald Darling date 6/13/77 Signed Donald Darling Authorized representative		

Forward the white, blue and pink copies to the Department of Health and Environment

Form WWC-5