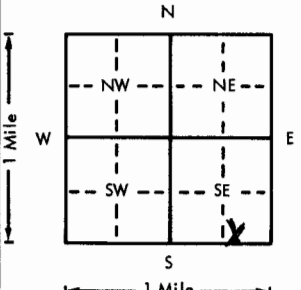


USE TYPEWRITER OR BALL  
POINT PEN-PRESS FIRMLY,  
PRINT CLEARLY.

WATER WELL RECORD  
KSA 82a-1201-1215

Kansas Department of Health and  
Environment-Division of Environment  
(Water well Contractors)  
Topeka, Kansas 66620

1. Location of well:		County	Fraction	Section number	Township number	Range number
Mophaeagon		Sw 1/4 Se 1/4 Se 1/4	36	T 20 S R 4	E 1/4	
2. Distance and direction from nearest town or city: 2 N 2 1/2 E			3. Owner of well: Gerold Baerg			
Street address of well location if in city: Inman			R.R. or street: RRI			
			City, state, zip code: Inman, Mo. 67546			
4. Locate with "X" in section below:			Sketch map:			
						
5. Type and color of material			From	To	6. Bore hole dia. 10 in. Completion date 9-30-76	
Top Soil			0	2	Well depth 122 ft.	
Yellow + Red Clay			2	55	7. Cable tool X Rotary Driven Dug	
Medium Sand			55	80	Hollow rod Jetted Bored Reverse rotary	
Red Clay			80	92	8. Use: X Domestic Public supply Industry	
Medium to coarse Sand			92	117	Irrigation Air conditioning Stock	
Gray Clay			117	122	Lawn Oil field water Other	
					9. Casing: Material PVC Height: Above or below	
					Threaded Welded Surface 12 in.	
					RMP PVC X Weight 26440 lbs./ft.	
					Dia. 5 in. to 122 ft. depth Wall Thickness: inches or	
					Dia. in. to ft. depth gage No. 250	
					10. Screen: Manufacturer's name M.P.I.	
					Type PVC Dia. 5"	
					Slot/gauze 7/8 Length 10'	
					Set between 108 ft. and 118 ft.	
					Gravel pack? X Size range of material 4-30	
					11. Static water level: 35 ft. below land surface Date 9-30-76	
					12. Pumping level below land surfaces:	
					ft. after hrs. pumping g.p.m.	
					ft. after hrs. pumping g.p.m.	
					Estimated maximum yield g.p.m.	
					13. Water sample submitted: mo./day/yr.	
					Yes X No Date	
					14. Well head completion:	
					X Pitless adapter Inches above grade	
					15. Well grouted? X	
					With: Neat cement Bentonite X Concrete	
					Depth: From 3 ft. to 13 ft.	
					16. Nearest source of possible contamination: Septic tank	
					ft. 33 Direction J Type Tank	
					Well disinfected upon completion? X Yes No	
					17. Pump: X Not installed	
					Manufacturer's name	
					Model number HP Volts	
					Length of drop pipe ft. capacity g.p.m.	
					Type:	
					Submersible Turbine	
					Jet Reciprocating	
					Centrifugal Other	
18. Elevation:			19. Remarks: Owner to run concrete slab around well 4'x4'x4"		20. Water well contractor's certification:	
Topography:					This well was drilled under my jurisdiction and this report is true to the best of my knowledge and belief.	
Hill					Backhus Drg. 100	
Slope					Business name License No.	
X Upland					Address Tampa, Mo.	
Valley					Signed Paul Backhus Date 10-6-76	

Forward the white, blue and pink copies to the Department of Health and Environment

Form WWC-5