

## WATER WELL PLUGGING RECORD Form WWC-5P

KSA 82a-1212

ID NO.

23644

**1 LOCATION OF WATER WELL:** Fraction 1/4 NW 1/4 SW 1/4 SE 1/4 Section Number 12 Township Number T 20 S Range Number 4 ☐ E ☒ W  
 County: McPherson

Street/Rural Address of Well Location; if unknown, distance & direction from nearest town or intersection: If at owner's address, check here ☐ Approximately 1.5 miles west and

0.75 miles south of McPherson, KS

**Global Positioning Systems (GPS) information:**

Latitude: 38.32205 (in decimal degrees)

Longitude: 97.71233 (in decimal degrees)

Elevation: \_\_\_\_\_

Datum: ☐ WGS84, ☐ NAD83, ☒ NAD27

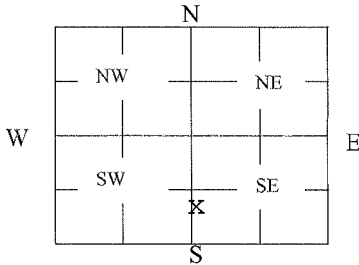
Collection Method: \_\_\_\_\_

☒ GPS unit (Make/Model: Garmin GPSmap 60CSx)

☐ Digital Map/Photo, ☐ Topographic Map, ☐ Land Survey

Est. Accuracy: ☐ < 3 m, ☒ 3-5 m, ☐ 5-15 m, ☐ > 15 m

**2 WATER WELL OWNER:** Doris E. Swanson  
 RR#, St. Address, Box #: 1001 K-61 Hwy  
 City, State ZIP Code: McPherson, KS 67460

**3 MARK WELL'S LOCATION WITH AN "X" IN SECTION BOX:****4 DEPTH OF WELL** 200 **ft.**

WELL'S STATIC WATER LEVEL 81 ft

WELL WAS USED AS:

☐ Domestic  
☒ Irrigation  
☐ Feedlot  
☐ Industrial

☐ Public Water Supply  
☐ Oil Field Water Supply  
☐ Domestic (Lawn & Garden)  
☐ Air Conditioning

☐ Dewatering  
☐ Monitoring  
☐ Injection Well  
☐ Other \_\_\_\_\_

Was a chemical/bacteriological sample submitted to Department? Yes ☐ No ☒

**5 TYPE OF BLANK CASING USED:**

☐ Steel  
☐ PVC

☐ RMP (SR)  
☐ ABS

☐ Wrought  
☒ Asbestos-Cement

☐ Fiberglass  
☐ Concrete Tile

☐ Other (Specify below) \_\_\_\_\_

Blank casing diameter 16 in. Was casing pulled? Yes ☐ No ☒ If yes, how much \_\_\_\_\_  
 Casing height above or below land surface below 36 in.

**6 GROUT PLUG MATERIAL:** ☐ Neat cement ☒ Cement grout ☐ Bentonite ☐ Other \_\_\_\_\_

Grout Plug Intervals: From 81 ft. to 3 ft., From \_\_\_\_\_ ft. to \_\_\_\_\_ ft., From \_\_\_\_\_ to \_\_\_\_\_ ft.

What is the nearest source of possible contamination:

☐ Septic tank  
☐ Sewer lines  
☐ Watertight sewer lines  
☐ Lateral lines  
☐ Cess pool

☐ Seepage pit  
☐ Pit privy  
☐ Sewage lagoon  
☐ Feedyard  
☐ Livestock pens

☐ Fuel Storage  
☐ Fertilizer storage  
☐ Insecticide storage  
☐ Abandoned water well  
☐ Oil well/Gas well

☒ Other (specify below)  
New K-61 HWY construction

Direction from well? East  
 How many feet? 1000

RECEIVED

MAY 17 2011

BUREAU OF WATER

FROM	TO	PLUGGING MATERIALS	FROM	TO	PLUGGING MATERIALS
200	81	Clean, coarse Sand			Well plugging witnessed by
81	3	Cement Grout			David Randolph, GMD2 staff, on
3	0	Topsoil			4/21/11 and 5/4/11

RECEIVED

MAY 12 2011

**7 CONTRACTOR'S OR LANDOWNER'S CERTIFICATION:** This water well was plugged under my jurisdiction and was completed on (mo/day/year) 5/4/11 and this record is true to the best of my knowledge and belief. Kansas Water Well Contractor's License No. \_\_\_\_\_. This Water Well Record was completed on (mo/day/year) 5/6/11 under the business name of \_\_\_\_\_ by (signature) Doris E. Swanson

Equus Beds Groundwater  
 Management District No. 2

**INSTRUCTIONS:** Use typewriter or ballpoint pen. Please press firmly and print clearly. Please fill in blanks, underline or circle the correct answers. Send top three copies to Kansas Department of Health and Environment, Bureau of Water, Geology Section, 1000 SW Jackson St., Ste. 420, Topeka, Kansas 66612-1367. Telephone: 785/296-5524. Send one to Water Well Owner and retain one for your records. Visit us at <http://www.kdheks.gov/waterwell/index.html>.

Check one: ☐ White Copy ☐ Blue Copy ☐ Pink Copy