


1 LOCATION OF WATER WELL: Fraction NE 1/4 SE 1/4 SE 1/4 Section Number 36 Township Number T 20 S Range Number R 6 E

County: Rice Distance and direction from nearest town or city street address of well if located within city? 10 mi N of Hutchinson - 1885 31st Rd

2 WATER WELL OWNER: Tom Webster Board of Agriculture, Division of Water Resources  
 RR#, St. Address, Box #: 1885 31st Rd Application Number:  
 City, State, ZIP Code: Tyman, KS 67546

3 LOCATE WELL'S LOCATION WITH AN "X" IN SECTION BOX: 4 DEPTH OF COMPLETED WELL: 48 ft. ELEVATION:

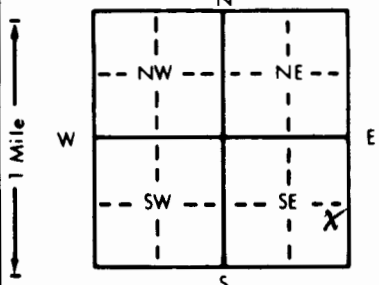

Depth(s) Groundwater Encountered 1. 11 ft. 2. 11 ft. 3. 11 ft.  
 WELL'S STATIC WATER LEVEL 11 ft. below land surface measured on mo/day/yr 5-2-96  
 Pump test data: Well water was 4.6 ft. after 1 hours pumping 1.6 gpm  
 Est. Yield 1.6 gpm: Well water was 4.6 ft. after 1 hours pumping 1.6 gpm  
 Bore Hole Diameter 9 in. to 51 ft., and 51 in. to 51 ft.  
 WELL WATER TO BE USED AS:  
 Domestic     Feedlot     Oil field water supply     Dewatering     Other (Specify below)  
 Irrigation     Industrial     Lawn and garden only     Monitoring well  
 Was a chemical/bacteriological sample submitted to Department? Yes    No   ; If yes, mo/day/yr sample was submitted     
 Water Well Disinfected?  Yes     No

5 TYPE OF BLANK CASING USED:  
 1 Steel     3 RMP (SR)     6 Asbestos-Cement     9 Other (specify below)  
 2 PVC     4 ABS     7 Fiberglass  
 Blank casing diameter 5 in. to 38 ft., Dia    in. to    ft., Dia    in. to    ft.  
 Casing height above land surface 12 in., weight 2.29 lbs./ft. Wall thickness or gauge No. 160  
 CASING JOINTS: Glued    Clamped    Welded    Threaded   

TYPE OF SCREEN OR PERFORATION MATERIAL:  
 1 Steel     3 Stainless steel     5 Fiberglass     7 PVC     10 Asbestos-cement  
 2 Brass     4 Galvanized steel     6 Concrete tile     9 ABS     11 Other (specify)     
 12 None used (open hole)  
 SCREEN OR PERFORATION OPENINGS ARE:  
 1 Continuous slot     3 Mill slot     5 Gauzed wrapped     8 Saw cut     11 None (open hole)  
 2 Louvered shutter     4 Key punched     6 Wire wrapped     9 Drilled holes  
 7 Torch cut     10 Other (specify)   

SCREEN-PERFORATED INTERVALS: From 38 ft. to 48 ft., From    ft. to    ft., From    ft. to    ft.  
 GRAVEL PACK INTERVALS: From 23 ft. to 51 ft., From    ft. to    ft., From    ft. to    ft.

6 GROUT MATERIAL:  1 Neat cement     2 Cement grout     3 Bentonite     4 Other     
 Grout Intervals: From 3 ft. to 23 ft., From    ft. to    ft., From    ft. to    ft.  
 What is the nearest source of possible contamination:  
 1 Septic tank     4 Lateral lines     7 Pit privy     10 Livestock pens     14 Abandoned water well  
 2 Sewer lines     5 Cess pool     8 Sewage lagoon     11 Fuel storage     15 Oil well/Gas well  
 3 Watertight sewer lines     6 Seepage pit     9 Feedyard     12 Fertilizer storage     16 Other (specify below)     
 13 Insecticide storage  
 Direction from well? W How many feet? 225

FROM	TO	LITHOLOGIC LOG	FROM	TO	PLUGGING INTERVALS
0	12	Sandy br silt			
12	38	Br + Gr clay			
38	43	Conglomerate			
43	51	shale			

7 CONTRACTOR'S OR LANDOWNER'S CERTIFICATION: This water well was  constructed, (2) reconstructed, or (3) plugged under my jurisdiction and was completed on (mo/day/year) 5-2-96 and this record is true to the best of my knowledge and belief. Kansas Water Well Contractor's License No. 447 This Water Well Record was completed on (mo/day/yr) 5-29-96 under the business name of Miller Drilling by (signature) [Signature]

INSTRUCTIONS: Use typewriter or ball point pen. PLEASE PRESS FIRMLY and PRINT clearly. Please fill in blanks, underline or circle the correct answers. Send top three copies to Kansas Department of Health and Environment, Bureau of Water, Topeka, Kansas 66620-0001. Telephone: 913-296-5545. Send one to WATER WELL OWNER and retain one for your records.