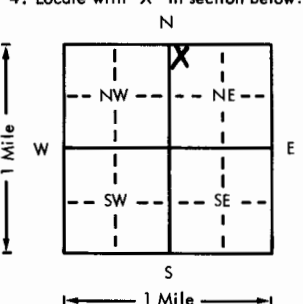


USE TYPEWRITER OR BALL POINT PEN—PRESS FIRMLY, PRINT CLEARLY.

WATER WELL RECORD  
KSA 82a-1201-1215

Kansas Department of Health and Environment—Division of Environment (Water well Contractors)  
Topeka, Kansas 66620

1. Location of well:	County <b>Rice</b>	Fraction <b>NW 1/4 NW 1/4 NE 1/4</b>	Section number <b>9</b>	Township number <b>T 20 S R 6 W E 1/4</b>	Range number
2. Distance and direction from nearest town or city: <b>4 1/2 m S 1 1/2 E of Little River, Ks.</b>			3. Owner of well: <b>Irvin Hodgson R.R. Little River, Ks. 67457</b>		
4. Locate with "X" in section below: 			6. Bore hole dia. <b>10</b> in. Completion date <b>10/20/76</b> Well depth <b>27</b> ft.		
5. Type and color of material			7. <input checked="" type="checkbox"/> Cable tool <input checked="" type="checkbox"/> Rotary <input type="checkbox"/> Driven <input type="checkbox"/> Dug <input type="checkbox"/> Hollow rod <input type="checkbox"/> Jetted <input type="checkbox"/> Bored <input type="checkbox"/> Reverse rotary		
From			8. Use: <input checked="" type="checkbox"/> Domestic <input type="checkbox"/> Public supply <input type="checkbox"/> Industry <input type="checkbox"/> Irrigation <input type="checkbox"/> Air conditioning <input type="checkbox"/> Stock <input type="checkbox"/> Lawn <input type="checkbox"/> Oil field water <input type="checkbox"/> Other		
To			9. Casing: Material <b>plst</b> Height: Above or below <input checked="" type="checkbox"/> Threaded <input type="checkbox"/> Welded <input type="checkbox"/> Surface <b>12</b> in. RMP <input checked="" type="checkbox"/> PVC <input type="checkbox"/> Weight <b>1.95</b> lbs./ft. Dia. <b>6</b> in. to <b>21</b> ft. depth Wall Thickness: inches or Dia. <input type="checkbox"/> in. to <input type="checkbox"/> ft. depth gage No. <b>200</b>		
topsoil			10. Screen: Manufacturer's name <b>none</b> Type <input type="checkbox"/> Dia. <input type="checkbox"/> Slot/gauze <input type="checkbox"/> Length <input type="checkbox"/> Set between <input type="checkbox"/> ft. and <input type="checkbox"/> ft. <input type="checkbox"/> ft. and <input type="checkbox"/> ft. Gravel pack? <b>no</b> Size range of material <input type="checkbox"/>		
clay light brown/small layers of white rock			11. Static water level: <input type="checkbox"/> mo./day/yr. <b>21.5</b> ft. below land surface Date <b>10/20/76</b>		
2			12. Pumping level below land surfaces: <b>23</b> ft. after <b>1</b> hrs. pumping <b>40</b> g.p.m. <input type="checkbox"/> ft. after <input type="checkbox"/> hrs. pumping <input type="checkbox"/> g.p.m. Estimated maximum yield <b>45</b> g.p.m.		
27			13. Water sample submitted: <input type="checkbox"/> mo./day/yr. <input checked="" type="checkbox"/> Yes <input type="checkbox"/> No Date <b>10/76</b>		
(Use a second sheet if needed)			14. Well head completion: <input type="checkbox"/> Pitless adapter <b>12</b> Inches above grade		
			15. Well grouted? <b>yes</b> With: <input type="checkbox"/> Neat cement <input type="checkbox"/> Bentonite <input checked="" type="checkbox"/> Concrete Depth: From <b>8</b> ft. to <b>20</b> ft.		
			16. Nearest source of possible contamination: ft. <b>150</b> Direction <b>N</b> Type <b>septic</b> Well disinfected upon completion? <input checked="" type="checkbox"/> Yes <input type="checkbox"/> No		
			17. Pump: <input checked="" type="checkbox"/> Not installed Manufacturer's name <input type="checkbox"/> Model number <input type="checkbox"/> HP <input type="checkbox"/> Volts <input type="checkbox"/> Length of drop pipe <input type="checkbox"/> ft. capacity <input type="checkbox"/> g.p.m. Type: <input type="checkbox"/> Submersible <input type="checkbox"/> Turbine <input type="checkbox"/> Jet <input type="checkbox"/> Reciprocating <input type="checkbox"/> Centrifugal <input type="checkbox"/> Other		
18. Elevation:			20. Water well contractor's certification: This well was drilled under my jurisdiction and this report is true to the best of my knowledge and belief. <b>Miller Water Well Serv. 137</b> Business name <input type="checkbox"/> License No. <input type="checkbox"/> Address <b>Hutchinson, Ks.</b> Signed <b>Joe Miller</b> <b>10/24/76</b> Date Authorized representative		
Topography: <input type="checkbox"/> Hill <input checked="" type="checkbox"/> Slope <input checked="" type="checkbox"/> Upland <input type="checkbox"/> Valley			19. Remarks: <b>A cavity in the clay at 24ft. produces water. Casing was grouted to a 3" layer of hard white rock at 20'. The water tested high in nitrates but seems to be improving with use.</b>		

T 20 S R 6 W E 1/4