USE TYPEWRITER OR BALL POINT PEN-PRESS FIRMLY, PRINT CLEARLY.

WATER WELL RECORD
KSA 82a-1201-1215

Kansas Department of Health and Environment-Division of Environment
(Water well Contractors)
Topeka, Kansas 66620

| 1. Location of well: | County | Fraction | Section number | Township number | Range number |
|---|---|---|---|---|---|
| | Rice | NE 1/4 NW 1/4 NW 1/4 | 20 | T 20 S | R 6 E/W |

2. Distance and direction from nearest town or city: 6 mi. S 1/4 E of Little, River, Ks.
Street address of well location if in city:

3. Owner of well: Robert W Johnson
R.R. or street: 310 E 13th
City, state, zip code: Hutchinson, Ks. 67501

4. Locate with "X" in section below:

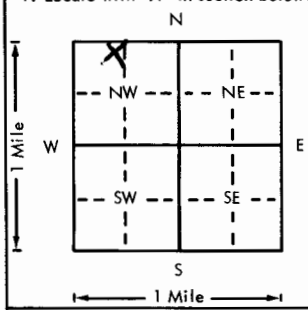


Sketch map:

6. Bore hole dia. 8 in. Completion date 5-25-77
Well depth 27 ft.

7. __ Cable tool X Rotary __ Driven __ Dug
__ Hollow rod __ Jetted __ Bored __ Reverse rotary

8. Use: X Domestic __ Public supply __ Industry
__ Irrigation __ Air conditioning __ Stock
__ Lawn __ Oil field water __ Other

9. Casing: Material PIST
Threaded ___ Welded ___
RMP X PVC ___
Dia. 5 in. to 27 ft. depth
Dia. ___ in. to ___ ft. depth
Height: Above or below Surface 24 in.
Weight 1.55 lbs./ft.
Wall Thickness: inches or gage No. #200

10. Screen: Manufacturer's name J+L
Type RMP Dia. 5"
Slot/gauze .030 Length 10'
Set between 17 ft. and 27 ft.
___ ft. and ___ ft.
Gravel pack? yes Size range of material E-1/2"

11. Static water level: mo./day/yr.
9 ft. below land surface Date 5-25-77

12. Pumping level below land surfaces:
23 ft. after 1/4 hrs. pumping 10 g.p.m.
23 ft. after 1 hrs. pumping 6 g.p.m.
Estimated maximum yield 6 g.p.m.

13. Water sample submitted: mo./day/yr.
__ Yes X No Date

14. Well head completion:
X Pitless adapter 24 Inches above grade

15. Well grouted? yes
With: X Neat cement ___ Bentonite ___ Concrete
Depth: From 3 ft. to 13 ft.

16. Nearest source of possible contamination:
ft. 15 Direction W Type Old Well
Well disinfected upon completion? X Yes ___ No

17. Pump: X Not installed
Manufacturer's name
Model number HP Volts
Length of drop pipe ft. capacity g.p.m.
Type:
__ Submersible __ Turbine
__ Jet __ Reciprocating
__ Centrifugal __ Other

5. Type and color of material

| | From | To |
|---|---|---|
| Silt + sand | 0 | 10 |
| Clay gray | 10 | 13 |
| Clay gray + yellow | 13 | 18 |
| Fine sand + sand stone light gray | 18 | 25 |
| Clay + silty clay gray | 25 | 29 |

(Use a second sheet if needed)

18. Elevation:
Topography:
__ Hill
__ Slope
X Upland
__ Valley

19. Remarks: Pump installer will plug old well. His name is Don Miller of Little River, Ks.

20. Water well contractor's certification:
This well was drilled under my jurisdiction and this report is true to the best of my knowledge and belief.
Business name Miller Water Well Serv. 137 License No.
Address Hutchinson, Ks
Signed Joe Miller Date
Authorized representative 5-25-77

T 20 R 6 E Sec 20 NE 1/4 NW 1/4 NW 1/4

Forward the white, blue and pink copies to the Department of Health and Environment

Form WWC-5