


USE TYPEWRITER OR BALL POINT PEN—PRESS FIRMLY, PRINT CLEARLY.

WATER WELL RECORD
KSA 82a-1201-1215

Kansas State Dept. Of Health
(Water Well Contractors)
Forbes-Bldg. 740
Topeka, Kansas 66620

1 Location of well: County Rice Township name Rockville Fraction NE 1/4 SE 1/4 Section number 23 Town number T205 Range number R 6 W

Distance and direction from nearest town or city: Street address of well location if in city: 3 Owner of well: Marion Swabby Address: 311 South Grand

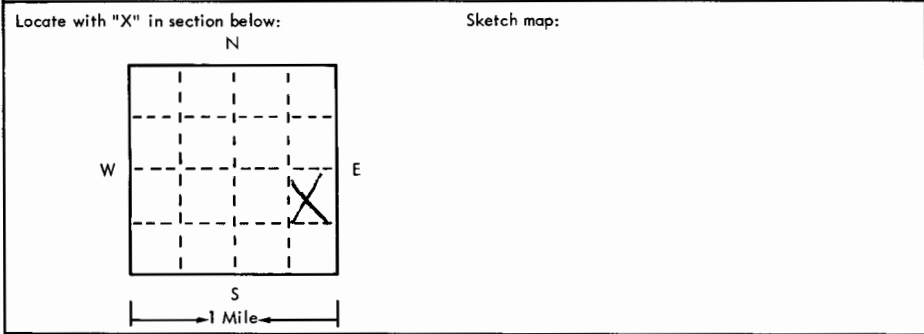

4 Well depth: 47 ft. Date of completion 11-21-74
Well diameter 09 in.
5 Cable tool Rotary Driven Dug
 Hollow rod Jetted Bored Reverse rotary
6 Use: Domestic Public supply Industry
 Irrigation Air conditioning Commercial
 Test well Human + Stock
7 Casing: Material PLAS Height: above below
Threaded Welded Surface 12 in.
Diam. 4 Weight 4 lbs./ft.
6 in. to 48 ft. depth Drive shoe? Yes No
 in. to ft. depth

2	Type and color of material	From	To
	Soil	1	3
	Clay	3	25
	Sandy clay	25	24
	Sandy broken shale	25	40
	Red shale	40	60

8 Screen: Manufacturer PLAS Certain Teed
Type PVC Dia. 6
Slot/gauze 1/16 Length 20
Set between 28 ft. and 48 ft.
Fittings: Gravel pack Yes No Size range of material 1/4

9 Static water level: 110 ft. below land surface Date 11-21-74

10 Pumping level below land surfaces:
____ ft. after ____ hrs. pumping ____ g.p.m.
____ ft. after ____ hrs. pumping ____ g.p.m.
Estimated maximum yield 15 g.p.m.

11 Water sample submitted: Yes No Date ____

12 Well head completion: Pitless adapter 12 inches above grade

13 Well grouted? Yes No
 Neat cement Bentonite ____
Depth: From 5 ft. to 15 ft.

14 Nearest source of possible contamination: abandoned well
ft. 30 Direction West
Well disinfected upon completion? Yes No
with casing collapsed

15 Pump: Not installed
Manufacturer's name ____ HP ____ Volts ____
Length of drop pipe ____ ft. capacity ____ g.p.m.
Type: Submersible Turbine
 Jet Reciprocating
 Centrifugal Other

16 Remarks: elevation
Topography: Hill Slope Upland Valley

17 Water well contractor's certification:
This well was drilled under my jurisdiction and this report is true to the best of my knowledge and belief.
Arthur Varney License No. 147
Business name ____ Address Jays Park
Signed Arthur Varney Date 11-21-74
Authorized representative