


1 LOCATION OF WATER WELL: Fraction NE 1/4 SE 1/4 SE 1/4 Section Number 35 Township Number T 20 S Range Number R 6 E/W
 County: Rice

Distance and direction from nearest town or city street address of well if located within city?
 12 miles North of Hutchinson on Plum st.-1mile west-1/4 mile North

2 WATER WELL OWNER: Fred Walton
 RR#, St. Address, Box #: RR 2 Board of Agriculture, Division of Water Resources
 City, State, ZIP Code: Sterling, Ks. 67579 Application Number:

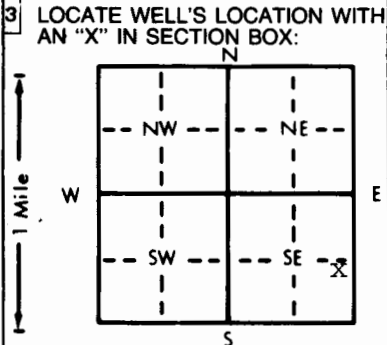

4 DEPTH OF COMPLETED WELL...145'... ft. ELEVATION:
 Depth(s) Groundwater Encountered 1. ft. 2. ft. 3. ft.
 WELL'S STATIC WATER LEVEL7..... ft. below land surface measured on mo/day/yr3-7-92.
 Pump test data: Well water was ft. after hours pumping gpm
 Est. Yield gpm: Well water was ft. after hours pumping gpm
 Bore Hole Diameter 7 7/8 in. to ft., and in. to ft.
 WELL WATER TO BE USED AS: 5 Public water supply 8 Air conditioning 11 Injection well
 1 Domestic 3 Feedlot 6 Oil field water supply 9 Dewatering 12 Other (Specify below)
 2 Irrigation 4 Industrial 7 Lawn and garden only 10 Monitoring well Stock
 Was a chemical/bacteriological sample submitted to Department? Yes.....No.....X.....; If yes, mo/day/yr sample was sub-
 mitted Water Well Disinfected? Yes X No

5 TYPE OF BLANK CASING USED: 5 Wrought iron 8 Concrete tile CASING JOINTS: Glued X Clamped
 1 Steel 3 RMP (SR) 6 Asbestos-Cement 9 Other (specify below) Welded
 2 PVC 4 ABS 7 Fiberglass Threaded
 Blank casing diameter5.....in. to6.5.....ft., Diain. toft., Diain. toft.
 Casing height above land surface28.....in., weightlbs./ft. Wall thickness or gauge No.258
 TYPE OF SCREEN OR PERFORATION MATERIAL: 7 PVC 10 Asbestos-cement
 1 Steel 3 Stainless steel 5 Fiberglass 8 RMP (SR) 11 Other (specify)
 2 Brass 4 Galvanized steel 6 Concrete tile 9 ABS 12 None used (open hole)
 SCREEN OR PERFORATION OPENINGS ARE: 5 Gauzed wrapped 8 Saw cut 11 None (open hole)
 1 Continuous slot 3 Mill slot 6 Wire wrapped 9 Drilled holes
 2 Louvered shutter 4 Key punched 7 Torch cut 10 Other (specify)
 SCREEN-PERFORATED INTERVALS: From6.5.....ft. to145.....ft., Fromft. toft.
 From145.....ft. to20.....ft., Fromft. toft.
 GRAVEL PACK INTERVALS: Fromft. toft., Fromft. toft.
 Fromft. toft., Fromft. toft.

6 GROUT MATERIAL: 1 Neat cement 2 Cement grout 3 Bentonite 4 OtherHole Plug
 Grout Intervals: From20.....ft. to3.....ft., Fromft. toft., Fromft. toft.
 What is the nearest source of possible contamination:
 1 Septic tank 4 Lateral lines 7 Pit privy 10 Livestock pens 14 Abandoned water well
 2 Sewer lines 5 Cess pool 8 Sewage lagoon 11 Fuel storage 15 Oil well/Gas well
 3 Watertight sewer lines 6 Seepage pit 9 Feedyard 12 Fertilizer storage 16 Other (specify below)
 13 Insecticide storagenone

Direction from well? How many feet?

FROM	TO	LITHOLOGIC LOG	FROM	TO	PLUGGING INTERVALS
0	3	Top soil			
3	6	Clay			
6	45	Red Shale			
45	55	Green Shale			
55	65	Red shale			
65	100	Red & Green shale			
100	105	Green shale			
105	145	Red & Green shale			

7 CONTRACTOR'S OR LANDOWNER'S CERTIFICATION: This water well was (1) constructed, (2) reconstructed, or (3) plugged under my jurisdiction and was completed on (mo/day/year) 3-7-92 and this record is true to the best of my knowledge and belief. Kansas Water Well Contractor's License No. 134 This Water Well Record was completed on (mo/day/yr) 4-24-92 under the business name of Rosencrantz-Bemis by (signature) [Signature]

INSTRUCTIONS: Use typewriter or ball point pen. PLEASE PRESS FIRMLY and PRINT clearly. Please fill in blanks, underline or circle the correct answers. Send top three copies to Kansas Department of Health and Environment, Bureau of Water Protection, Topeka, Kansas 66620-7320. Telephone: 913-296-5514. Send one to WATER WELL OWNER and retain one for your records.