

Plotted


USE TYPEWRITER OR BALL POINT PEN-PRESS FIRMLY, PRINT CLEARLY.

WATER WELL RECORD
KSA 82a-1201-1215

Kansas Department of Health and Environment-Division of Environment (Water well Contractors) Topeka, Kansas 66620

1. Location of well:	County Rice	Fraction c 1/4 ne 1/4 -nw 1/4	Section number 7	Township number T 20 S	Range number R 7 E
----------------------	-----------------------	---	----------------------------	----------------------------------	------------------------------

2. Distance and direction from nearest town or city: 1S-2E-1/4 of Lyons, Ks Street address of well location if in city:	3. Owner of well: American Salt R.R. or street: Box 498 City, state, zip code: Lyons, Ks.
--	--

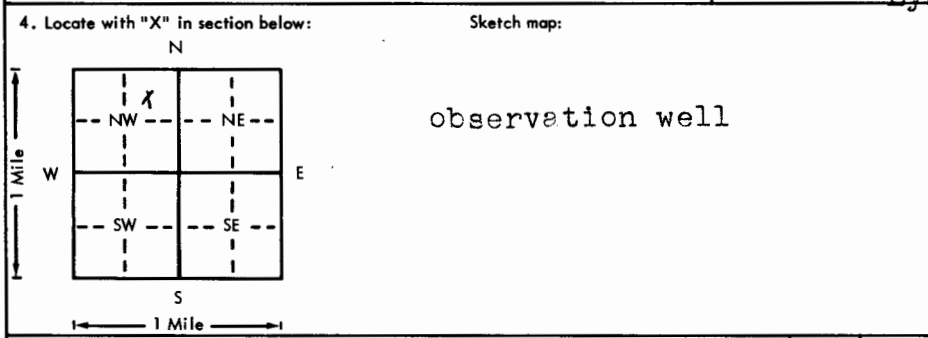

6. Bore hole dia. 11 in. Completion date _____ Well depth 61 ft. 1/10/76
7. <input type="checkbox"/> Cable tool <input checked="" type="checkbox"/> Rotary <input type="checkbox"/> Driven <input type="checkbox"/> Dug <input type="checkbox"/> Hollow rod <input type="checkbox"/> Jetted <input type="checkbox"/> Bored <input type="checkbox"/> Reverse rotary
8. Use: <input type="checkbox"/> Domestic <input type="checkbox"/> Public supply <input checked="" type="checkbox"/> Industry <input type="checkbox"/> Irrigation <input type="checkbox"/> Air conditioning <input type="checkbox"/> Stock <input type="checkbox"/> Lawn <input type="checkbox"/> Oil field water <input type="checkbox"/> Other
9. Casing: Material _____ Height: Above or below _____ Threaded _____ Welded <input checked="" type="checkbox"/> Surface 18 in. RMP _____ PVC <input checked="" type="checkbox"/> Weight 160 lbs./ft. Dia. 4 in. to 61 ft. depth Wall Thickness: inches or _____ Dia. _____ in. to _____ ft. depth gage No. _____

5. Type and color of material	From	To
Top soil	0	2
Brown clay	2	14
Sand and gravel	14	58
Red shale	58	61
Bedrock 58'		

10. Screen: Manufacturer's name _____ R & B Type pvc Dia. 6 Slot/gauze 1/16 Length _____ Set between 51 ft. and 61 ft. _____ ft. and _____ ft.
11. Static water level: _____ mo./day/yr. 15 ft. below land surface Date 1/10/76
12. Pumping level below land surfaces: na _____ ft. after _____ hrs. pumping _____ g.p.m. _____ ft. after _____ hrs. pumping _____ g.p.m. Estimated maximum yield _____ g.p.m.
13. Water sample submitted: _____ mo./day/yr. Yes _____ No _____ Date _____
14. Well head completion: <input type="checkbox"/> Pitless adapter 18 inches above grade
15. Well grouted? _____ With: <input checked="" type="checkbox"/> Neat cement <input type="checkbox"/> Bentonite <input type="checkbox"/> Concrete Depth: From 0 ft. to 10 ft.
16. Nearest source of possible contamination: ft. 10 Direction west Type salt pit Well disinfected upon completion? _____ Yes _____ No
17. Pump: <input checked="" type="checkbox"/> Not installed Manufacturer's name _____ Model number _____ HP _____ Volts _____ Length of drop pipe _____ ft. capacity _____ g.p.m. Type: <input type="checkbox"/> Submersible <input type="checkbox"/> Turbine <input type="checkbox"/> Jet <input type="checkbox"/> Reciprocating <input type="checkbox"/> Centrifugal <input type="checkbox"/> Other

18. Elevation: 1720 Topo	19. Remarks: 4 m
Topography: <input type="checkbox"/> Hill <input type="checkbox"/> Slope <input type="checkbox"/> Upland <input checked="" type="checkbox"/> Valley	

20. Water well contractor's certification: This well was drilled under my jurisdiction and this report is true to the best of my knowledge and belief. osancrantz-Bemis 134 Business name License No. Address Great Bend, Ks. Signed Indira Redson Date 4/4/76 Authorized representative
--

20
7
7
C NE NW
1/4
1/4
1/4