

Plotted

USE TYPEWRITER OR BALL POINT PEN-PRESS FIRMLY, PRINT CLEARLY.


WATER WELL RECORD  
KSA 82a-1201-1215

Kansas Department of Health and Environment-Division of Environment (Water well Contractors) Topeka, Kansas 66620

DA

1. Location of well:	County <b>Rice</b>	Fraction <b>c 1/4 ne 1/4 nw 1/4</b>	Section number <b>7</b>	Township number <b>T 20 S</b>	Range number <b>R 7 E/W</b>
----------------------	-----------------------	--	----------------------------	----------------------------------	--------------------------------

2. Distance and direction from nearest town or city: <b>1s-2e-1s of Lyons, Ks</b> Street address of well location if in city:	3. Owner of well: <b>American Salt</b> R.R. or street: <b>Box 498</b> City, state, zip code: <b>Lyons, Ks.</b>
---	---

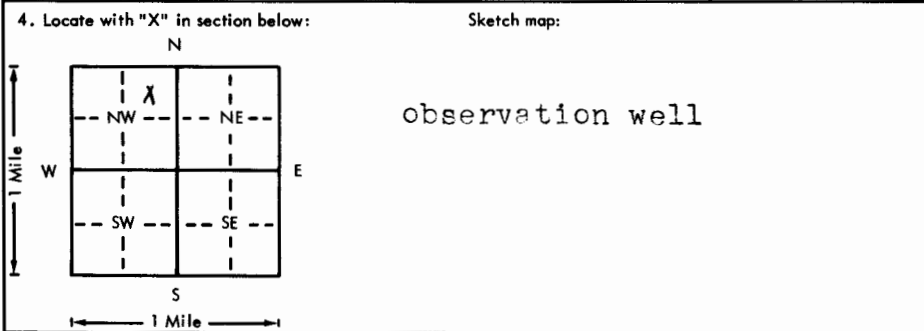

6. Bore hole dia. <b>1 1/2</b> in. Completion date _____ Well depth <b>61</b> ft. <b>1/9/76</b>
7. <input checked="" type="checkbox"/> Cable tool <input checked="" type="checkbox"/> Rotary <input type="checkbox"/> Driven <input type="checkbox"/> Dug <input type="checkbox"/> Hollow rod <input type="checkbox"/> Jetted <input type="checkbox"/> Bored <input type="checkbox"/> Reverse rotary
8. Use: <input type="checkbox"/> Domestic <input type="checkbox"/> Public supply <input checked="" type="checkbox"/> Industry <input type="checkbox"/> Irrigation <input type="checkbox"/> Air conditioning <input type="checkbox"/> Stock <input type="checkbox"/> Lawn <input type="checkbox"/> Oil field water <input type="checkbox"/> Other
9. Casing: Material _____ Height: Above or below _____ Threaded _____ Welded <input checked="" type="checkbox"/> Surface <b>18</b> in. RMP _____ PVC <input checked="" type="checkbox"/> Weight <b>160</b> lbs./ft. Dia. <b>5</b> in. to <b>61</b> ft. depth Wall Thickness: inches or Dia. _____ in. to _____ ft. depth gage No. _____

5. Type and color of material	From	To
Top soil	0	2
Brown clay	2	14
Sand and gravel	14	58
Red shale	58	61
Bedrock 58'		

10. Screen: Manufacturer's name <b>R &amp; B</b> Type <b>pvc</b> Dig. <b>6</b> Slot/gauge <b>slot 1/16</b> Length _____ Set between <b>15</b> ft. and <b>30</b> ft. <b>51</b> ft. and <b>61</b> ft. Gravel pack? <input checked="" type="checkbox"/> Size range of material <b>3/3/4</b> 5/8
11. Static water level: _____ mo./day/yr. <b>15</b> ft. below land surface Date <b>1-9-76</b>
12. Pumping level below land surfaces: _____ ft. after _____ hrs. pumping <b>NA</b> g.p.m. _____ ft. after _____ hrs. pumping _____ g.p.m. Estimated maximum yield _____ g.p.m.
13. Water sample submitted: _____ mo./day/yr. Yes _____ No _____ Date _____
14. Well head completion: <input type="checkbox"/> Pitless adapter <b>18</b> inches above grade
15. Well grouted? _____ With: <input checked="" type="checkbox"/> Neat cement _____ Bentonite _____ Concrete _____ Depth: From <b>0</b> ft. to <b>10</b> ft.
16. Nearest source of possible contamination: ft. <b>10</b> Direction <b>west</b> Type <b>salt pit</b> Well disinfected upon completion? _____ Yes _____ No
17. Pump: <input checked="" type="checkbox"/> Not installed Manufacturer's name _____ Model number _____ HP _____ Volts _____ Length of drop pipe _____ ft. capacity _____ g.p.m. Type: <input type="checkbox"/> Submersible <input type="checkbox"/> Turbine <input type="checkbox"/> Jet <input type="checkbox"/> Reciprocating <input type="checkbox"/> Centrifugal <input type="checkbox"/> Other

18. Elevation: <b>1720</b> Top	19. Remarks: <i>these wells of American salt was drilled within 300' of each other</i>	20. Water well contractor's certification: This well was drilled under my jurisdiction and this report is true to the best of my knowledge and belief. <b>Rosencrantz-Bemis 134</b> Business name _____ License No. _____ Address <b>Great Bend, Ks.</b> Signed <b>Julia Hedson</b> Date <b>4/10/76</b> Authorized representative
-----------------------------------	---	---

20-70-7  
T  
R  
Sec  
1/4  
1/4  
1/4  
NE NW