

Plotted

USE TYPEWRITER OR BALL POINT PEN-PRESS FIRMLY, PRINT CLEARLY.

T R EW sec 1/4 1/4 1/4 No.

WATER WELL RECORD
KSA 82a-1201-1215


Kansas State Dept. Of Health
(Water Well Contractors)
Forbes-Bldg. 740
Topeka, Kansas 66620

BAA

1 Location of well: County Rice Township name Wilson Fraction NE 1/4 NW 1/4 Section number 17 Town number T 20 S Range number R 7 W

Distance and direction from nearest town or city: 2.5 mi. N + 0.5 mi. W of Salaman, KS
Street address of well location if in city: Saxman

3 Owner of well: Paul Westrup Route 1
Address: Lyons Kansas 67554

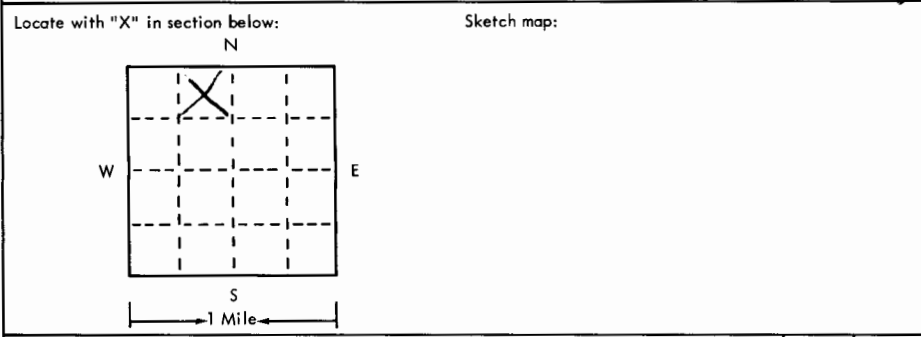

4 Well depth: 60 ft. Date of completion 11-14-74
Well diameter 4 1/2 in.

5 Cable tool Rotary Driven Dug
 Hollow rod Jetted Bored Reverse rotary

6 Use: Domestic Public supply Industry
 Irrigation Air conditioning Commercial
 Test well HUMAN

7 Casing: Material PVC Height: above below
Threaded Welded Surface 1 1/2 in. AB
Diam. 2 lbs./ft. Weight 2 lbs./ft.
6 in. to 60 ft. depth Drive shoe? Yes No
 in. to ft. depth

2	Type and color of material	From	To
	<u>Grail</u>	<u>5</u>	<u>10</u>
	<u>Clay</u>	<u>10</u>	<u>40</u>
	<u>Fine sand</u>	<u>40</u>	<u>50</u>
	<u>Gravel</u>	<u>50</u>	<u>60</u>
	<u>Red shale</u>	<u>60</u>	<u>Bot.</u>
	<u>Bedrock 60'</u>		

8 Screen: Manufacturer PLAC Certain Teed
Type PVE Dia. 6"
Slot gauge 1/16 Length 10 ft
Set between 50 ft. and 60 ft.
Fittings: Gravel pack Yes No Size range of material 1/4

9 Static water level: 35 ft. below land surface Date 11-14-74

10 Pumping level below land surfaces:
 ft. after hrs. pumping g.p.m.
 ft. after hrs. pumping g.p.m.
Estimated maximum yield 50 g.p.m.

11 Water sample submitted: Yes No Date 11-14-74

12 Well head completion: Pitless adapter 12 Inches above grade

13 Well grouted? Yes No
 Neat cement Bentonite
Depth: From 5 ft. to 15 ft.

14 Nearest source of possible contamination: 50 ft. Direction North Type collapsed
Well disinfected upon completion? Yes No old well casing

15 Pump: Not installed
Manufacturer's name
Model number HP Volts
Length of drop pipe ft. capacity g.m.p.
Type: Submersible Turbine
 Jet Reciprocating
 Centrifugal Other

16 Remarks: elevation 1677 Topo Topo

Topography:
 Hill
 Slope
 Upland
 Valley

17 Water well contractor's certification:
This well was drilled under my jurisdiction and this report is true to the best of my knowledge and belief.
Arthur W. Parney 147
Business name License No.
Address Lyons Kansas
Signed Arthur W. Parney Date 11-14-74
Authorized representative