


1 LOCATION OF WATER WELL: County: Rice Fraction: NW 1/4 SW 1/4 SW 1/4 Section Number: 20 Township Number: T 20 S Range Number: R 7 W E/W

Distance and direction from nearest town or city street address of well if located within city?
3/4 mile North of Saxton, on East Side

2 WATER WELL OWNER: American Salt Company
 RR#, St. Address, Box #: Box 498 Board of Agriculture, Division of Water Resources
 City, State, ZIP Code: Lyons, Kansas 67554 Application Number:

3 LOCATE WELL'S LOCATION WITH AN "X" IN SECTION BOX:

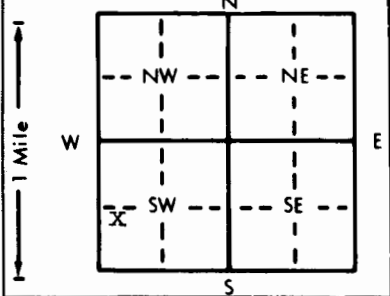

4 DEPTH OF COMPLETED WELL: 30 ft. ELEVATION:

Depth(s) Groundwater Encountered 1. ft. 2. ft. 3. ft.
 WELL'S STATIC WATER LEVEL: 21 ft. below land surface measured on mo/day/yr May 16, 1985
 Pump test data: Well water was ft. after hours pumping gpm
 Est. Yield gpm: Well water was ft. after hours pumping gpm
 Bore Hole Diameter: 8 in. to ft., and in. to ft.
 WELL WATER TO BE USED AS:
 Domestic Public water supply Air conditioning Injection well
 Irrigation Feedlot Oil field water supply Dewatering Other (Specify below)
 2 4 7 10
 Was a chemical/bacteriological sample submitted to Department? Yes.....No.......; If yes, mo/day/yr sample was submitted
 Water Well Disinfected? Yes No

5 TYPE OF BLANK CASING USED:
 1 Steel 2 PVC 3 RMP (SR) 4 ABS 5 Wrought iron 6 Asbestos-Cement 7 Fiberglass 8 Concrete tile 9 Other (specify below)
 CASING JOINTS: Glued Clamped Welded Threaded

Blank casing diameter: 6 in. to 25 ft., Dia. in. to ft., Dia. in. to ft.
 Casing height above land surface: 18 in., weight lbs./ft. Wall thickness or gauge No.

TYPE OF SCREEN OR PERFORATION MATERIAL:
 1 Steel 2 Stainless steel 3 Fiberglass 4 RMP (SR) 5 Asbestos-cement 6 Brass 7 Galvanized steel 8 Concrete tile 9 ABS 10 Other (specify)
 11 None used (open hole)

SCREEN OR PERFORATION OPENINGS ARE:
 1 Continuous slot 2 Mill slot 3 Wire wrapped 4 Saw cut 5 None (open hole)
 2 Louvered shutter 4 Key punched 7 Torch cut 9 Drilled holes 11 Other (specify)

SCREEN-PERFORATED INTERVALS: From 25 ft. to 30 ft., From ft. to ft.
 GRAVEL PACK INTERVALS: From 10 ft. to 30 ft., From ft. to ft.

6 GROUT MATERIAL: 1 Neat cement 2 Cement grout 3 Bentonite 4 Other
 Grout Intervals: From 0 ft. to 10 ft., From ft. to ft.

What is the nearest source of possible contamination:
 1 Septic tank 4 Lateral lines 7 Pit privy 10 Livestock pens 14 Abandoned water well
 2 Sewer lines 5 Cess pool 8 Sewage lagoon 11 Fuel storage 15 Oil well/Gas well
 3 Watertight sewer lines 6 Seepage pit 9 Feedyard 12 Fertilizer storage 16 Other (specify below)
 None

Direction from well? How many feet?

FROM	TO	LITHOLOGIC LOG	FROM	TO	LITHOLOGIC LOG
0	3	Top Soil			
3	20	Clay			
20	27	Meduim sand			
27	30	Clay & fine sand			

7 CONTRACTOR'S OR LANDOWNER'S CERTIFICATION: This water well was (1) constructed, (2) reconstructed, or (3) plugged under my jurisdiction and was completed on (mo/day/year) May 16, 1985 and this record is true to the best of my knowledge and belief. Kansas Water Well Contractor's License No. 134 This Water Well Record was completed on (mo/day/yr) May 24, 1985

under the business name of Rosencrantz & Bemis Enterprise by (signature) Mike Flowers by Chris Sheriff
 INSTRUCTIONS: Use typewriter or ball point pen, PLEASE PRESS FIRMLY and PRINT clearly. Please fill in blanks, underline or circle the correct answers. Send to three copies to Kansas Department of Health and Environment, Division of Environment, Environmental Geology Section, Topeka, KS 66620. Send one to WATER WELL OWNER and retain one for your records.