USE TYPEWRITER OR BALL POINT PEN-PRESS FIRMLY, PRINT CLEARLY.

T	R	EW	sec 1/4	1/4	1/4	No.				

WATER WELL RECORD
KSA 82a-1201-1215

Kansas State Dept. Of Health
(Water Well Contractors)
Forbes-Bldg. 740
Topeka, Kansas 66620

1 Location of well:	County	Township name	Fraction	Section number	Town number	Range number
	Rice	Wilson	N-W-¼ S-W-¼	20	20	7

Distance and direction from nearest town or city: 1 mile north of Salman Kans.

Street address of well location if in city:

3 Owner of well: Lyle Brothers

Address: Lyons Kans. R. 2

Locate with "X" in section below:

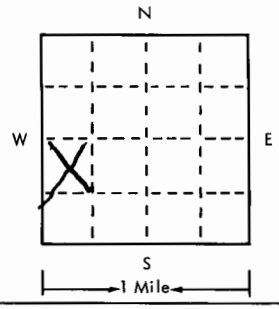

Sketch map:

4 Well depth: 45 ft. Date of completion 6-29-76
Well diameter 9 in.

5 ☐ Cable tool ☒ Rotary ☐ Driven ☐ Dug
☐ Hollow rod ☐ Jetted ☐ Bored ☐ Reverse rotary

6 Use: ☒ Domestic ☐ Public supply ☐ Industry
☐ Irrigation ☐ Air conditioning ☐ Commercial
☐ Test well ☐ Human - stock

7 Casing: Material Plast Height: above/below
Threaded ☐ Welded ☒ Surface 12 in.
Diam. Weight 3 lbs./ft. 1
5 in. to 45 ft. depth Drive shoe? ☐ Yes ☒ No
in. to ft. depth

2

Type and color of material	From	To
Soil	0	10
Clay	10	20
Fine sand	20	34
Blue clay	34	35
Corse gravel	35	45
(use a second sheet if needed)		

8 Screen:
Manufacturer Centerstead
Type PVC Dia. 5 in.
Slot/gauze 40 Length 10
Set between 35 ft. and 45 ft.
Fittings:
Gravel pack ☒ Yes ☐ No Size range of material 1/4

9 Static water level:
22 ft. below land surface Date 6-22-76

10 Pumping level below land surfaces:
ft. after hrs. pumping g.p.m.
ft. after hrs. pumping g.p.m.
Estimated maximum yield 60 g.p.m.

11 Water sample submitted:
☐ Yes ☒ No Date

12 Well head completion:
☐ Pitless adapter ☒ Inches above grade 12 in.

13 Well grouted? ☒ Yes ☐ No
☒ Neat cement ☐ Bentonite ☐
Depth: From 0 ft. to 10 ft.

14 Nearest source of possible contamination:
ft. 150 Direction West Type
Well disinfected upon completion? ☒ Yes ☐ No

15 Pump: ☒ Not installed
Manufacturer's name
Model number HP Volts
Length of drop pipe ft. capacity g.m.p.
Type:
☐ Submersible ☐ Turbine
☐ Jet ☐ Reciprocating
☐ Certrifugal ☐ Other

16 Remarks: elevation

Topography:
☐ Hill
☐ Slope
☐ Upland
☒ Valley

17 Water well contractor's certification:
This well was drilled under my jurisdiction and this report is true to the best of my knowledge and belief.
Arthur Varney
Business name License No.
Address Lyons Kans. 147
Signed Arthur Varney Date 6-22-76
Authorized representative

20 7W 20 NWSW