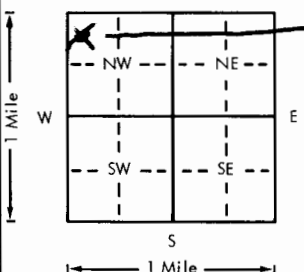


USE TYPEWRITER OR BALL POINT PEN-PRESS FIRMLY, PRINT CLEARLY.

WATER WELL RECORD
KSA 82a-1201-1215

Kansas Department of Health and Environment-Division of Environment (Water well Contractors) Topeka, Kansas 66620

1. Location of well: County RICE Fraction NW 1/4 NW 1/4 NW 1/4 Section number 24 Township number T 20 S R 7 Range number 7	
2. Distance and direction from nearest town or city: 6 mi South AND 2 mi WEST OF LITTLE RIVER, KS. 3. Owner of well: DRANE VAN HORN R.R. or street: R.R. #1 Box 113 City, state, zip code: LYONS, KANSAS 67554	
4. Locate with "X" in section below: Sketch map:  DOMESTIC WELL	
5. Type and color of material	
	From To
Top Soil	0 5
White Clay	5 26
Brown Clay	26 38
Brown Sandy Clay	38 58
Brown Sandy Clay with small sand layers	58 63
GRAY Clay	63 68
GREEN SHALE	68 70
(Use a second sheet if needed)	
18. Elevation:	19. Remarks:
Topography: <input type="checkbox"/> Hill <input type="checkbox"/> Slope <input checked="" type="checkbox"/> Upland <input type="checkbox"/> Valley	20. Water well contractor's certification: This well was drilled under my jurisdiction and this report is true to the best of my knowledge and belief. PETERSON IRRIGATION 138 Business name License No. Address Box 150 LINDSBORG, KS Signed Mike Peterson Date 11-14-78 Authorized representative

6. Bore hole dia. 8 in. Completion date 11-14-78 Well depth 65 ft.
7. <input checked="" type="checkbox"/> Cable tool <input checked="" type="checkbox"/> Rotary <input type="checkbox"/> Driven <input type="checkbox"/> Dug <input type="checkbox"/> Hollow rod <input type="checkbox"/> Jetted <input type="checkbox"/> Bored <input type="checkbox"/> Reverse rotary
8. Use: <input checked="" type="checkbox"/> Domestic <input type="checkbox"/> Public supply <input type="checkbox"/> Industry <input type="checkbox"/> Irrigation <input type="checkbox"/> Air conditioning <input type="checkbox"/> Stock <input type="checkbox"/> Lawn <input type="checkbox"/> Oil field water <input type="checkbox"/> Other
9. Casing: Material _____ Height Above or below Threaded _____ Welded _____ Surface 24 in. RMP _____ PVC <input checked="" type="checkbox"/> Weight 2 lbs./ft. Dia. 4 in. to 45 ft. depth Wall Thickness: inches or Dia. _____ in. to _____ ft. depth gage No. 125 in
10. Screen: Manufacturer's name PEERLESS PLASTICS Type PVC Dia. 4" Slot/gauze 1/32 Length 20ft Set between 45 ft. and 65 ft. ft. and _____ ft. Gravel pack? YES Size range of material 1/4 in
11. Static water level: _____ mo./day/yr. 9 ft. below land surface Date 11-14-78
12. Pumping level below land surfaces: 12 ft. after 2 hrs. pumping 12 g.p.m. _____ ft. after _____ hrs. pumping _____ g.p.m. Estimated maximum yield 20-30 g.p.m.
13. Water sample submitted: _____ mo./day/yr. <input type="checkbox"/> Yes <input checked="" type="checkbox"/> No Date _____
14. Well head completion: <input type="checkbox"/> Pitless adapter 24 Inches above grade
15. Well grouted? YES With: <input checked="" type="checkbox"/> Neat cement <input type="checkbox"/> Bentonite <input type="checkbox"/> Concrete Depth: From 4 ft. to 14 ft.
16. Nearest source of possible contamination: NEW SEWER ft. 300 Direction South Type SEWER Well disinfected upon completion? <input checked="" type="checkbox"/> Yes <input type="checkbox"/> No
17. Pump: <input checked="" type="checkbox"/> Not installed Manufacturer's name _____ Model number _____ HP _____ Volts _____ Length of drop pipe _____ ft. capacity _____ g.p.m. Type: <input type="checkbox"/> Submersible <input type="checkbox"/> Turbine <input type="checkbox"/> Jet <input type="checkbox"/> Reciprocating <input type="checkbox"/> Centrifugal <input type="checkbox"/> Other

20-70-24 NW 1/4 NW 1/4