USE TYPEWRITER OR BALL POINT PEN-PRESS FIRMLY, PRINT CLEARLY.

T R EW sec 1/4 1/4 1/4 No.

WATER WELL RECORD
KSA 82a-1201-1215

Kansas State Dept. Of Health
(Water Well Contractors)
Forbes-Bldg. 740
Topeka, Kansas 66620

1 Location of well:	County	Township name	Fraction	Section number	Town number	Range number
	Rice	Wilson	NW 1/4 SW 1/4	26	T 20 S	R 7 West

Distance and direction from nearest town or city: 3 miles east of

Street address of well location if in city: Salman and 3/4 mi. N.

3 Owner of well: Paul Scheufler

Address: R 2 Sterling Kans. 67579

Locate with "X" in section below:

Sketch map:

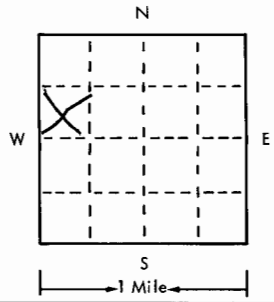

4 Well depth 60 ft. Date of completion June 17-1975

Well diameter 9 in.

5 ☐ Cable tool ☒ Rotary ☐ Driven ☐ Dug ☐ Hollow rod ☐ Jetted ☐ Bored ☐ Reverse rotary

6 Use: ☒ Domestic ☐ Public supply ☐ Industry ☐ Irrigation ☐ Air conditioning ☐ Commercial ☐ Test well ☐ Stock well

7 Casing: Material Plast Height: above/below

Threaded ☐ Welded ☒ Surface 12 in. above

Diam. Weight 4 lbs./ft. 1

6 in. to 60 ft. depth Drive shoe? ☐ Yes ☒ No

in. to ft. depth

2

Type and color of material	From	To
Sand	1	20
Clay	20	40
Rocky clay	40	60
(use a second sheet if needed)		

8 Screen:

Manufacturer certinteed

Type PVC plast Dia. 6 in

Slot/gauze 1/16 Length 30 ft

Set between 30 ft. and 60 ft.

Fittings:

Gravel pack ☒ Yes ☐ No Size range of material 1/4

9 Static water level:

23 ft. below land surface Date 6-17-1975

10 Pumping level below land surfaces:

ft. after hrs. pumping g.p.m.

ft. after hrs. pumping g.p.m.

Estimated maximum yield 20 g.p.m.

11 Water sample submitted:

☐ Yes ☒ No Date

12 Well head completion:

☐ Pitless adapter 12 ☒ Inches above grade

13 Well grouted? ☒ Yes ☐ No

☒ Neat cement ☐ Bentonite ☐

Depth: From 1 ft. to 10 ft.

14 Nearest source of possible contamination: emergency well

ft. 100 Direction north W Type gas well

Well disinfected upon completion? ☒ Yes ☐ No

15 Pump: ☒ Not installed

Manufacturer's name

Model number HP Volts

Length of drop pipe ft. capacity g.m.p.

Type:

☐ Submersible ☐ Turbine

☐ Jet ☐ Reciprocating

☐ Certrifugal ☐ Other

16 Remarks: elevation

Topography:

☐ Hill

☐ Slope

☒ Upland

☐ Valley

Pasture well

17 Water well contractor's certification:

This well was drilled under my jurisdiction and this report is true to the best of my knowledge and belief.

Business name Arthur Varney License No. 147

Address Lyons Kans.

Signed Arthur Varney Date 6-17-1975

Authorized representative

Forward the white, blue and pink copies to the Kansas State Dept. Of Health.

Form WWC-5