


1 LOCATION OF WATER WELL:		Fraction	Section Number	Township Number	Range Number
County: Rice		NE 1/4 NW 1/4 SE 1/4	32	T 20 S	R 7 EW

Distance and direction from nearest town or city street address of well if located within city?  
 Approximately 1 mile south and 3/4 mile east of Saxman

2 WATER WELL OWNER: Turner and Boisseau Chartered  
 RR#, St. Address, Box #: 3900 Broadway Board of Agriculture, Division of Water Resources  
 City, State, ZIP Code: Great Bend, KS 67530 Application Number:

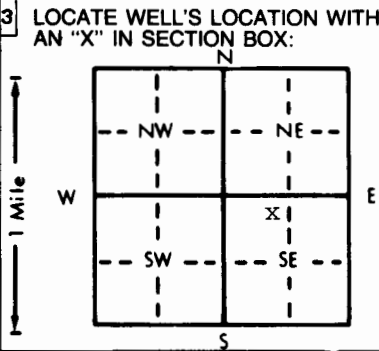

4 DEPTH OF COMPLETED WELL: 67 ft. ELEVATION: unknown  
 Depth(s) Groundwater Encountered 1. ft. 2. ft. 3. ft.  
 WELL'S STATIC WATER LEVEL: 9.5 ft. below land surface measured on mo/day/yr 10-12-93  
 Pump test data: Well water was not ch'd ft. after hours pumping gpm  
 Est. Yield unknown gpm Well water was ft. after hours pumping gpm  
 Bore Hole Diameter: 6 1/4 in. to 65 ft., and in. to ft.  
 WELL WATER TO BE USED AS:  
 1 Domestic 3 Feedlot 6 Oil field water supply 9 Dewatering 12 Other (Specify below)  
 2 Irrigation 4 Industrial 7 Lawn and garden only 10 Monitoring well  
 Was a chemical/bacteriological sample submitted to Department? Yes No X If yes, mo/day/yr sample was submitted Water Well Disinfected? Yes No X

5 TYPE OF BLANK CASING USED:  
 1 Steel 3 RMP (SR) 5 Wrought iron 8 Concrete tile CASING JOINTS: Glued X Clamped  
 2 PVC 4 ABS 6 Asbestos-Cement 9 Other (specify below) Welded  
 7 Fiberglass Threaded  
 Blank casing diameter 2 in. to 55 ft. Dia in. to ft. Dia in. to ft.  
 Casing height above land surface 24 in. weight .44 lbs./ft. Wall thickness or gauge No. .091  
 TYPE OF SCREEN OR PERFORATION MATERIAL:  
 1 Steel 3 Stainless steel 5 Fiberglass 7 PVC 10 Asbestos-cement  
 2 Brass 4 Galvanized steel 6 Concrete tile 8 RMP (SR) 11 Other (specify)  
 9 ABS 12 None used (open hole)  
 SCREEN OR PERFORATION OPENINGS ARE:  
 1 Continuous slot 3 Mill slot 5 Gauzed wrapped 8 Saw cut 11 None (open hole)  
 2 Louvered shutter 4 Key punched 6 Wire wrapped 9 Drilled holes  
 7 Torch cut 10 Other (specify)  
 SCREEN-PERFORATED INTERVALS: From 55 ft. to 65 ft. From ft. to ft.  
 From ft. to ft. From ft. to ft.  
 GRAVEL PACK INTERVALS: From 53 ft. to 65 ft. From ft. to ft.  
 From ft. to ft. From ft. to ft.

6 GROUT MATERIAL: 1 Neat cement 2 Cement grout 3 Bentonite 4 Other Bentonite Holeplug  
 Grout intervals: From ft. to ft. From ft. to ft. From 0 ft. to 53 ft.  
 What is the nearest source of possible contamination:  
 1 Septic tank 4 Lateral lines 7 Pit privy 10 Livestock pens 14 Abandoned water well  
 2 Sewer lines 5 Cess pool 8 Sewage lagoon 11 Fuel storage 15 Oil well/Gas well  
 3 Watertight sewer lines 6 Seepage pit 9 Feedyard 12 Fertilizer storage 16 Other (specify below)  
 13 Insecticide storage None known

Direction from well? How many feet?

FROM	TO	LITHOLOGIC LOG	FROM	TO	PLUGGING INTERVALS
0	2	Topsoil			
2	7	Clay, brown, hard, silty			
7	15	Sand and gravel, fine, medium, loose, slightly silty			
15	17	Clay, brown, soft, silty			
17	25	Sand and gravel, fine, medium, loose, clean			
25	35	Sand and gravel, fine, medium, loose, clean, thin clay streaks			
35	62.5	Sand and gravel, fine, medium, coarse, loose, clean			
62.5	65	Shale, red			

7 CONTRACTOR'S OR LANDOWNER'S CERTIFICATION: This water well was (1) constructed, (2) reconstructed, or (3) plugged under my jurisdiction and was completed on (mo/day/year) 10-12-93 and this record is true to the best of my knowledge and belief. Kansas Water Well Contractor's License No. 185 This Water Well Record was completed on (mo/day/yr) 10-21-93 under the business name of Clarke Well & Equipment, Inc. by (signature)