


1 LOCATION OF WATER WELL: County: Rice	Fraction NW ¼ SW ¼ NE ¼	Section Number 33	Township Number T 20 S	Range Number R 7 E/W
---	----------------------------	----------------------	---------------------------	-------------------------

Distance and direction from nearest town or city street address of well if located within city?
 Approximately 3/4 mile south and 1 1/2 miles east of Saxman

2 WATER WELL OWNER: Turner and Boisseau Chartered
 RR#, St. Address, Box #: 3900 Broadway Board of Agriculture, Division of Water Resources
 City, State, ZIP Code: Great Bend, KS 67530 Application Number:

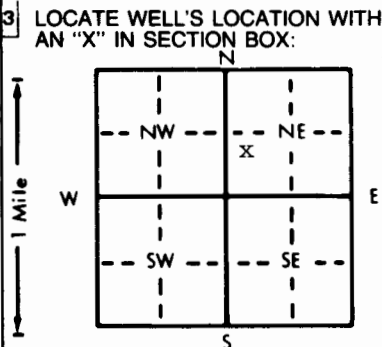

4 DEPTH OF COMPLETED WELL: 54.5 ft. ELEVATION: unknown
 Depth(s) Groundwater Encountered 1. _____ ft. 2. _____ ft. 3. _____ ft.
 WELL'S STATIC WATER LEVEL: 18.54 ft. below land surface measured on mo/day/yr 10-13-93
 Pump test data: Well water was not ch'd. ft. after _____ hours pumping _____ gpm
 Est. Yield unknown gpm: Well water was _____ ft. after _____ hours pumping _____ gpm
 Bore Hole Diameter: 6 1/4 in. to 55 ft., and _____ in. to _____ ft.
 WELL WATER TO BE USED AS:
 5 Public water supply 8 Air conditioning 11 Injection well
 1 Domestic 3 Feedlot 6 Oil field water supply 9 Dewatering 12 Other (Specify below)
 2 Irrigation 4 Industrial 7 Lawn and garden only 10 Monitoring well
 Was a chemical/bacteriological sample submitted to Department? Yes _____ No X _____; If yes, mo/day/yr sample was submitted _____
 Water Well Disinfected? Yes _____ No X _____

5 TYPE OF BLANK CASING USED:
 1 Steel 3 RMP (SR) 5 Wrought iron 8 Concrete tile CASING JOINTS: Glued X Clamped _____
 2 PVC 4 ABS 6 Asbestos-Cement 9 Other (specify below) Welded _____
 7 Fiberglass Threaded _____
 Blank casing diameter 2 in. to 42.5 ft., Dia _____ in. to _____ ft., Dia _____ in. to _____ ft.
 Casing height above land surface 24 in., weight .44 lbs./ft. Wall thickness or gauge No. .091
 TYPE OF SCREEN OR PERFORATION MATERIAL:
 1 Steel 3 Stainless steel 5 Fiberglass 7 PVC 10 Asbestos-cement
 2 Brass 4 Galvanized steel 6 Concrete tile 8 RMP (SR) 11 Other (specify) _____
 9 ABS 12 None used (open hole)
 SCREEN OR PERFORATION OPENINGS ARE:
 1 Continuous slot 3 Mill slot 5 Gauzed wrapped 8 Saw cut 11 None (open hole)
 2 Louvered shutter 4 Key punched 6 Wire wrapped 9 Drilled holes
 7 Torch cut 10 Other (specify) _____
 SCREEN-PERFORATED INTERVALS: From 42.5 ft. to 52.5 ft., From _____ ft. to _____ ft.
 GRAVEL PACK INTERVALS: From 36 ft. to 55 ft., From _____ ft. to _____ ft.

6 GROUT MATERIAL: 1 Neat cement 2 Cement grout 3 Bentonite 4 Other Bentonite Holeplug
 Grout Intervals: From _____ ft. to _____ ft., From _____ ft. to _____ ft., From 0 ft. to 36 ft.
 What is the nearest source of possible contamination:
 1 Septic tank 4 Lateral lines 7 Pit privy 10 Livestock pens 14 Abandoned water well
 2 Sewer lines 5 Cess pool 8 Sewage lagoon 11 Fuel storage 15 Oil well/Gas well
 3 Watertight sewer lines 6 Seepage pit 9 Feedyard 12 Fertilizer storage 16 Other (specify below)
 13 Insecticide storage None known
 Direction from well? _____ How many feet? _____

FROM	TO	LITHOLOGIC LOG	FROM	TO	PLUGGING INTERVALS
0	4	Topsoil			
4	9	Clay, brown, hard, silty			
9	23	Clay, tan			
23	52.5	Sand and gravel, fine, medium, coarse, loose, clean			
52.5	55	Shale, red, hard			

7 CONTRACTOR'S OR LANDOWNER'S CERTIFICATION: This water well was (1) constructed, (2) reconstructed, or (3) plugged under my jurisdiction and was completed on (mo/day/year) 10-13-93 and this record is true to the best of my knowledge and belief. Kansas Water Well Contractor's License No. 185 This Water Well Record was completed on (mo/day/yr) 10-21-93 under the business name of Clarke Well & Equipment, Inc. by (signature) _____