USE TYPEWRITER OR BALL POINT PEN-PRESS FIRMLY, PRINT CLEARLY.

T R EW sec 1/4 1/4 1/4 No.

WATER WELL RECORD
KSA 82a-1201-1215

Kansas State Dept. Of Health
(Water Well Contractors)
Forbes-Bldg. 740
Topeka, Kansas 66620

1 Location of well:	County	Township name	Fraction	Section number	Town number	Range number
	Rice	Wilson	NW¼ NE¼	35	T20S	R7W

Distance and direction from nearest town or city: 3 miles east of Lyman Kans.

Street address of well location if in city:

3 Owner of well: Larry Gates

Address: Sterling, Ks 67579

Locate with "X" in section below:

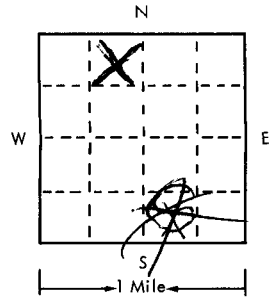

Sketch map:

4 Well depth: 42 ft. Date of completion May 20 19 75
Well diameter 14 in.

5 ☐ Cable tool ☒ Rotary ☐ Driven ☐ Dug
☐ Hollow rod ☐ Jetted ☐ Bored ☐ Reverse rotary

6 Use: ☒ Domestic ☐ Public supply ☐ Industry
☐ Irrigation ☐ Air conditioning ☐ Commercial
☐ Test well ☒ Stock

7 Casing: Material Plastic Height: above/below
Threaded ☐ Welded ☒ Surface 19 in. above
Diam. Weight 4 lbs./ft. 1
6 in. to 49 ft. depth Drive shoe? ☐ Yes ☒ No
___ in. to ___ ft. depth

2

Type and color of material	From	To
Sand	1	10
Clay	10	20
Fine sand	20	42
(use a second sheet if needed)		

8 Screen:
Manufacturer Certainteed
Type PVC plastic 6 in. x 1
Slot/gauze 1/16 in. Length 20 ft.
Set between 22 ft. and 42 ft.
Fittings:
Gravel pack ☒ Yes ☐ No Size range of material 1/4 in.

9 Static water level:
10 ft. below land surface Date 5-20-75

10 Pumping level below land surfaces:
___ ft. after ___ hrs. pumping ___ g.p.m.
___ ft. after ___ hrs. pumping ___ g.p.m.
Estimated maximum yield 15 g.p.m.

11 Water sample submitted:
☐ Yes ☒ No Date ___

12 Well head completion:
☐ Pitless adapter 12 ☒ Inches above grade

13 Well grouted? ☒ Yes ☐ No
☒ Neat cement ☐ Bentonite ☐ ___
Depth: From 1 ft. to 10 ft.

14 Nearest source of possible contamination:
ft. 1/2 mi. Direction South Type Good
Well disinfected upon completion? ☒ Yes ☐ No

15 Pump: ☒ Not installed
Manufacturer's name ___
Model number ___ HP ___ Volts ___
Length of drop pipe ___ ft. capacity ___ g.m.p.
Type:
☐ Submersible ☐ Turbine
☐ Jet ☐ Reciprocating
☐ Certrifugal ☐ Other

16 Remarks: elevation

Topography:
☐ Hill
☐ Slope
☒ Upland
☐ Valley

Pasture well

17 Water well contractor's certification:
This well was drilled under my jurisdiction and this report is true to the best of my knowledge and belief.
Arthur Warney 147
Business name License No.
Address Lyons, Kans.
Signed Arthur Warney Date 5-20-75
Authorized representative