


1 LOCATION OF WATER WELL: County: <u>Rice</u>	Fraction <u>- 1/4 NW 1/4 SW 1/4</u>	Section Number <u>3</u>	Township Number <u>T 20 S</u>	Range Number <u>R 8 E (W)</u>
--	--	----------------------------	----------------------------------	----------------------------------

Distance and direction from nearest town or city street address of well if located within city?
113' E & 4' S of SE cor of Bell & Jay

2 WATER WELL OWNER: RR#, St. Address, Box # : City, State, ZIP Code	<u>KDHE</u> <u>Forbes Field Bldg 740</u> <u>Topeka KS 66620-0001</u>	Board of Agriculture, Division of Water Resources Application Number:
---	--	--

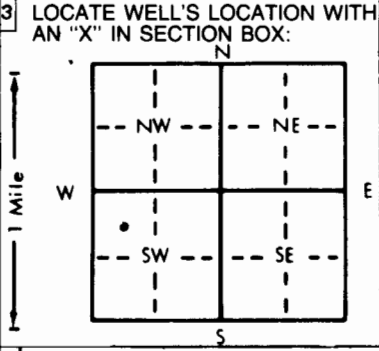

4 DEPTH OF COMPLETED WELL: <u>78.5</u> ft. ELEVATION: <u>1686.71 TC</u>
Depth(s) Groundwater Encountered 1. <u>40</u> ft. 2. _____ ft. 3. _____ ft.
WELL'S STATIC WATER LEVEL <u>37.08</u> ft. below land surface measured on mo/day/yr <u>10-23-95</u>
Pump test data: Well water was _____ ft. after _____ hours pumping _____ gpm
Est. Yield _____ gpm: Well water was _____ ft. after _____ hours pumping _____ gpm
Bore Hole Diameter: <u>8</u> in. to _____ ft., and _____ in. to _____ ft.
WELL WATER TO BE USED AS:
5 Public water supply 8 Air conditioning 11 Injection well
1 Domestic 3 Feedlot 6 Oil field water supply 9 Dewatering 12 Other (Specify below)
2 Irrigation 4 Industrial 7 Lawn and garden only <u>10 Monitoring well</u>
Was a chemical/bacteriological sample submitted to Department? Yes _____ No <u>X</u> _____; If yes, mo/day/yr sample was submitted
Water Well Disinfected? Yes _____ No <u>X</u> _____

5 TYPE OF BLANK CASING USED:	5 Wrought iron	8 Concrete tile	CASING JOINTS: Glued _____ Clamped _____
1 Steel	3 RMP (SR)	6 Asbestos-Cement	9 Other (specify below)
<u>2 PVC</u>	4 ABS	7 Fiberglass	Welded _____
Blank casing diameter <u>2</u> in. to _____ ft., Dia _____ in. to _____ ft., Dia _____ in. to _____ ft.			<u>Threaded</u> <u>Flush</u>
Casing height above land surface <u>Flush</u> in., weight <u>7.03</u> lbs./ft. Wall thickness or gauge No. <u>Sch 40</u>			
TYPE OF SCREEN OR PERFORATION MATERIAL:	<u>7 PVC</u>	10 Asbestos-cement	
1 Steel	3 Stainless steel	5 Fiberglass	8 RMP (SR)
2 Brass	4 Galvanized steel	6 Concrete tile	9 ABS
11 Other (specify) _____			12 None used (open hole)
SCREEN OR PERFORATION OPENINGS ARE:	5 Gauzed wrapped	8 Saw cut	11 None (open hole)
1 Continuous slot	<u>3 Mill slot</u>	6 Wire wrapped	9 Drilled holes
2 Louvered shutter	4 Key punched	7 Torch cut	10 Other (specify) _____
SCREEN-PERFORATED INTERVALS: From <u>68.5</u> ft. to <u>78.5</u> ft., From _____ ft. to _____ ft.			
GRAVEL PACK INTERVALS: From <u>58</u> ft. to <u>78.5</u> ft., From _____ ft. to _____ ft.			

6 GROUT MATERIAL:	1 Neat cement	<u>2 Cement grout</u>	<u>3 Bentonite</u>	4 Other _____
Grout Intervals: From <u>2</u> ft. to <u>54</u> ft., From <u>54</u> ft. to <u>58</u> ft., From _____ ft. to _____ ft.				
What is the nearest source of possible contamination:	1 Septic tank	4 Lateral lines	7 Pit privy	10 Livestock pens
	2 Sewer lines	5 Cess pool	8 Sewage lagoon	11 Fuel storage
	3 Watertight sewer lines	6 Seepage pit	9 Feedyard	12 Fertilizer storage
				13 Insecticide storage
				14 Abandoned water well
				15 Oil well/Gas well
				<u>16 Other (specify below)</u> <u>Salt Mine</u>
Direction from well?	How many feet?			

FROM	TO	LITHOLOGIC LOG	FROM	TO	PLUGGING INTERVALS
0	38	Silt			
38	50	Clay			
50	57	Sand			
57	64	Silt			
64	65.5	Sand			
65.5	69	Silt			
69	73	Sand			
73	78.5	Clay			

7 CONTRACTOR'S OR LANDOWNER'S CERTIFICATION: This water well was <u>(1) constructed</u> , <u>(2) reconstructed</u> , or <u>(3) plugged</u> under my jurisdiction and was completed on (mo/day/year) <u>10-23-95</u> and this record is true to the best of my knowledge and belief. Kansas Water Well Contractor's License No. <u>531</u> This Water Well Record was completed on (mo/day/yr) <u>11-2-95</u> under the business name of <u>GSI</u> by (signature) <u>Allison Irwin</u>
--