


1 LOCATION OF WATER WELL: Fraction SW 1/4 NW 1/4 SW 1/4 Section Number 3 Township Number T 20 S Range Number R 8 E  
 County: Rice

Distance and direction from nearest town or city street address of well if located within city?  
1' N & 1' W of SW cor of Alley Entrance Between K-96 & Bell

2 WATER WELL OWNER: KDHE  
 RR#, St. Address, Box #: Forbes Field, Bldg 740  
 City, State, ZIP Code: Topeka KS 66620-0001  
 Board of Agriculture, Division of Water Resources  
 Application Number:

3 LOCATE WELL'S LOCATION WITH AN "X" IN SECTION BOX:

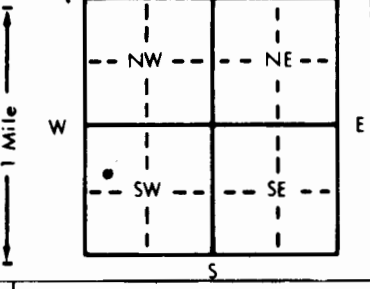

4 DEPTH OF COMPLETED WELL: 69 ft. ELEVATION: 1682.39 TC  
 Depth(s) Groundwater Encountered 1. 37.5 ft. 2. ft. 3. ft.  
 WELL'S STATIC WATER LEVEL: 33.37 ft. below land surface measured on mo/day/yr 10-23-95  
 Pump test data: Well water was ft. after hours pumping gpm  
 Est. Yield gpm: Well water was ft. after hours pumping gpm  
 Bore Hole Diameter: 8 in. to ft. and in. to ft.  
 WELL WATER TO BE USED AS:  
 1 Domestic 3 Feedlot 6 Oil field water supply 9 Dewatering 12 Other (Specify below)  
 2 Irrigation 4 Industrial 7 Lawn and garden only 10 Monitoring well  
 Water Well Disinfected? Yes No X  
 Water Well Disinfected? Yes No X

5 TYPE OF BLANK CASING USED:  
 1 Steel 3 RMP (SR) 5 Wrought iron 8 Concrete tile CASING JOINTS: Glued Clamped  
2 PVC 4 ABS 7 Fiberglass 9 Other (specify below) Welded  
 Blank casing diameter in. to ft., Dia. in. to ft., Dia. in. to ft.  
 Casing height above land surface: Flush in., weight 70.3 lbs./ft. Wall thickness or gauge No. Sch 40  
 TYPE OF SCREEN OR PERFORATION MATERIAL:  
 1 Steel 3 Stainless steel 5 Fiberglass 8 RMP (SR) 10 Asbestos-cement  
 2 Brass 4 Galvanized steel 6 Concrete tile 9 ABS 11 Other (specify)  
 12 None used (open hole)

SCREEN OR PERFORATION OPENINGS ARE:  
 1 Continuous slot 3 Mill slot 5 Gauzed wrapped 8 Saw cut 11 None (open hole)  
 2 Louvered shutter 4 Key punched 6 Wire wrapped 9 Drilled holes  
 7 Torch cut 10 Other (specify)

SCREEN-PERFORATED INTERVALS: From 59 ft. to 69 ft., From ft. to ft.  
 GRAVEL PACK INTERVALS: From 56.5 ft. to 69 ft., From ft. to ft.

6 GROUT MATERIAL: 1 Neat cement 2 Cement grout 3 Bentonite 4 Other  
 Grout Intervals: From 20 ft. to 52.5 ft., From 52.5 ft. to 56.5 ft., From ft. to ft.  
 What is the nearest source of possible contamination:  
 1 Septic tank 4 Lateral lines 7 Pit privy 10 Livestock pens 14 Abandoned water well  
 2 Sewer lines 5 Cess pool 8 Sewage lagoon 11 Fuel storage 15 Oil well/Gas well  
 3 Watertight sewer lines 6 Seepage pit 9 Feedyard 12 Fertilizer storage 16 Other (specify below)  
Sett Mine  
 Direction from well? How many feet?

FROM	TO	LITHOLOGIC LOG	FROM	TO	PLUGGING INTERVALS
0	43	Silt			
43	53	Sand			
53	62	Silt			
62	67.5	Sand			
67.5	69	Shale			

7 CONTRACTOR'S OR LANDOWNER'S CERTIFICATION: This water well was (1) constructed, (2) reconstructed, or (3) plugged under my jurisdiction and was completed on (mo/day/year) 10-23-95 and this record is true to the best of my knowledge and belief. Kansas Water Well Contractor's License No. 531 This Water Well Record was completed on (mo/day/yr) 11-2-95 under the business name of GST by (signature) Allison Irwin