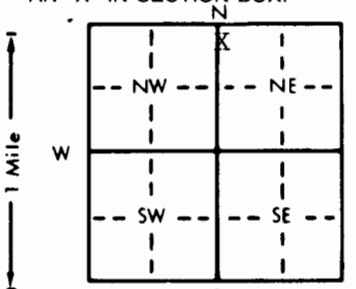


1 LOCATION OF WATER WELL: County: Rice Fraction: NW 1/4 NW 1/4 NE 1/4 Section Number: 2 Township Number: T 20 S Range Number: R 8W E/W

Distance and direction from nearest town or city street address of well if located within city?  
1 E of Lyons, Kansas

2 WATER WELL OWNER: Johnny Knighton  
 RR#, St. Address, Box # : 1750 Avenue M Board of Agriculture, Division of Water Resources  
 City, State, ZIP Code : Lyons, Kansas 67554 Application Number:

3 LOCATE WELL'S LOCATION WITH AN "X" IN SECTION BOX:  

 4 DEPTH OF COMPLETED WELL: 81 ft. ELEVATION: Unknown  
 Depth(s) Groundwater Encountered: 1.30 ft. 2.          ft. 3.          ft.  
 WELL'S STATIC WATER LEVEL: 30 ft. below land surface measured on mo/day/yr 6/10/96  
 Pump test data: Well water was          ft. after          hours pumping          gpm  
 Est. Yield: 8 gpm: Well water was          ft. after          hours pumping          gpm  
 Bore Hole Diameter: 7 7/8 in. to 8 1 in. and          in. to          in.  
 WELL WATER TO BE USED AS:  
 5 Public water supply 8 Air conditioning 11 Injection well  
 1 Domestic 3 Feedlot 6 Oil field water supply 9 Dewatering 12 Other (Specify below)  
 2 Irrigation 4 Industrial 7 Lawn and garden only 10 Monitoring well  
 Was a chemical/bacteriological sample submitted to Department? Yes          No         ; If yes, mo/day/yr sample was submitted  
 Water Well Disinfected? Yes          No         

5 TYPE OF BLANK CASING USED:  
 1 Steel 3 RMP (SR) 5 Wrought iron 8 Concrete tile CASING JOINTS: Glued Clamped  
 2 PVC 4 ABS 6 Asbestos-Cement 9 Other (specify below) Welded  
 7 Fiberglass          Threaded  
 Blank casing diameter: 5 in. to 31 in. Dia.          in. to          in. Dia.          in. to          in. Dia.  
 Casing height above land surface: 12 in. weight 2.8 lbs./ft. Wall thickness or gauge No. Sch. 40  
 TYPE OF SCREEN OR PERFORATION MATERIAL:  
 1 Steel 3 Stainless steel 5 Fiberglass 7 PVC 10 Asbestos-cement  
 2 Brass 4 Galvanized steel 6 Concrete tile 8 RMP (SR) 11 Other (specify)           
 12 None used (open hole)  
 SCREEN OR PERFORATION OPENINGS ARE:  
 1 Continuous slot 3 Mill slot 5 Gauzed wrapped 8 Saw cut 11 None (open hole)  
 2 Louvered shutter 4 Key punched 6 Wire wrapped 9 Drilled holes  
 7 Torch cut 10 Other (specify)           
 SCREEN-PERFORATED INTERVALS: From 31 ft. to 81 ft., From          ft. to          ft., From          ft. to          ft.  
 GRAVEL PACK INTERVALS: From 20 ft. to 81 ft., From          ft. to          ft., From          ft. to          ft.

6 GROUT MATERIAL: 1 Neat cement 2 Cement grout 3 Bentonite 4 Other           
 Grout Intervals: From 0 ft. to 20 ft., From          ft. to          ft., From          ft. to          ft.  
 What is the nearest source of possible contamination:  
 1 Septic tank 4 Lateral lines 7 Pit privy 10 Livestock pens 14 Abandoned water well  
 2 Sewer lines 5 Cess pool 8 Sewage lagoon 11 Fuel storage 15 Oil well/Gas well  
 3 Watertight sewer lines 6 Seepage pit 9 Feedyard 12 Fertilizer storage 16 Other (specify below)  
 Direction from well? SW How many feet? 45  
 13 Insecticide storage House

FROM	TO	LITHOLOGIC LOG	FROM	TO	PLUGGING INTERVALS
0	50	Top soil and mealy clay			
50	81	Sand rock streaks			

7 CONTRACTOR'S OR LANDOWNER'S CERTIFICATION: This water well was (1) constructed, (2) reconstructed, or (3) plugged under my jurisdiction and was completed on (mo/day/year) 6/10/96 and this record is true to the best of my knowledge and belief. Kansas Water Well Contractor's License No. 186. This Water Well Record was completed on (mo/day/yr) 6/12/96 under the business name of Kelly's Water Well Service, Inc. by (signature) Man's Good