


1 LOCATION OF WATER WELL: Fraction Section Number Township Number Range Number  
 County: RICE  $\frac{1}{4}$  NW  $\frac{1}{4}$  NW  $\frac{1}{4}$  NE 34 20 8 EW  
 Distance and direction from nearest town or city street address of well if located within city?

2 WATER WELL OWNER: Zimms Feedlot  
 RR #, St. Address, Box #: 1650 Ave. R Board of Agriculture, Division of Water Resources  
 City, State, ZIP Code: Steering KS, 67579 Application Number:

3 MARK WELL'S LOCATION WITH AN "X" IN SECTION BOX: DEPTH OF WELL ..... 24.3 ..... ft.  
 WELL'S STATIC WATER LEVEL ..... 19.1 ..... ft.  
 WELL WAS USED AS:  
 1 Domestic 5 Public Water Supply 9 Dewatering  
 2 Irrigation 6 Oil Field Water Supply  10 Monitoring Well  
 3 Feedlot 7 Domestic (Lawn & Garden) 11 Injection Well  
 4 Industrial 8 Air Conditioning 12 Other .....  
 Was a chemical / bacteriological sample submitted to Department? Yes ..... No   
 If yes, mo/day/yr sample was submitted .....  
 Water Well Disinfected: Yes ..... No

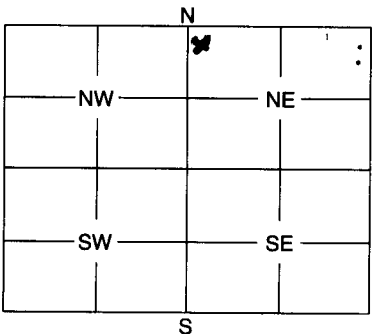

5 TYPE OF BLANK CASING USED:  
 1 Steel 3 RMP (SR) 5 Wrought 7 Fiberglass 9 Other (Specify below)  
 2 PVC 4 ABS 6 Asbestos-Cement 8 Concrete Tile .....  
 Blank casing diameter ..... 4 in. Was casing pulled? Yes ..... No  If yes, how much .....  
 Casing height above or below land surface ..... 36 in.

6 GROUT PLUG MATERIAL: 1 Neat cement 2 Cement grout  3 Bentonite 4 Other .....  
 Grout Plug Intervals: From 24.3 ft. to 3 ft., From ..... ft. to ..... ft., From ..... to ..... ft.  
 What is the nearest source of possible contamination:  
 1 Septic tank 6 Seepage pit 11 Fuel storage 16 Other (specify below)  
 2 Sewer lines 7 Pit privy 12 Fertilizer storage  
 3 Watertight sewer lines 8 Sewage lagoon 13 Insecticide storage  
 4 Lateral lines 9 Feedyard 14 Abandoned water well  
 5 Cess pool 10 Livestock pens 15 Oil well/Gas well  
 Direction from well? ..... SE ..... How many feet? ..... 150 ft .....

FROM	TO	PLUGGING MATERIALS
		<u>3/8 Bentonite Hole</u>
		<u>Plug Hydrated Every</u>
		<u>2 ft. Back to</u>
		<u>Surface</u>

RECEIVED  
 NOV 16 2004  
 BUREAU OF WATER

7 CONTRACTOR'S OF LANDOWNER'S CERTIFICATION: This water well was plugged under my jurisdiction and was completed on (mo/day/year) ..... 11-2-04 ..... and this record is true to the best of my knowledge and belief. Kansas Water Well Contractor's License No. 665 This Water Well Record was completed on (mo/day/year) 11-5-04 under the business name of Pratt Well Environmental by (signature) John Egan

INSTRUCTIONS: Use typewriter or ball point pen. Please press firmly and print clearly. Please fill in blanks, underline or circle the correct answers. Send top three copies to Kansas Department of Health and Environment, Bureau of Water, Geology Section, 1000 SW Jackson St., Ste. 420, Topeka, Kansas 66612-1367. Telephone: 785/296-5522. Send one to Water Well Owner and retain one for your records.