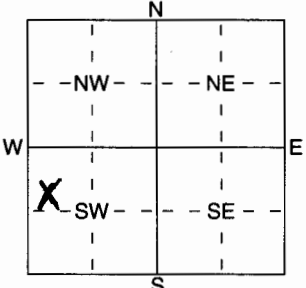


1	LOCATION OF WATER WELL: County: Rice	Fraction SW 1/4 NW 1/4 SW 1/4	Section Number 26	Township Number T 20 S	Range Number R 8 E/W
---	--	---	-----------------------------	----------------------------------	--------------------------------

Distance and direction from nearest town or city street address of well if located within city?

4 miles South & 1 mile East of Lyons, Ks.

2	WATER WELL OWNER: Roger Tobias RR#, St. Address, Box # : 1017 S. Bell City, State, ZIP Code : Lyons, Ks. 67554	Board of Agriculture, Division of Water Resources Application Number: 32,394
---	--	--

3	LOCATE WELL'S LOCATION WITH AN "X" IN SECTION BOX: 	4	DEPTH OF COMPLETED WELL 75 ft. ELEVATION:
Depth(s) Groundwater Encountered 1 ft. 2 ft. 3 ft. WELL'S STATIC WATER LEVEL 21 ft. below land surface measured on mo/day/yr Pump test data: Well water was ft. after hours pumping gppr Est. Yield 1100-1200 gppr Well water was ft. after hours pumping gppr WELL WATER TO BE USED AS: 1 Domestic 3 Feedlot 5 Public water supply 8 Air conditioning 11 Injection well <input checked="" type="checkbox"/> Irrigation 4 Industrial 6 Oil field water supply 9 Dewatering 12 Other (Specify below) 7 Domestic (lawn & garden) 10 Monitoring well			
Was a chemical/bacteriological sample submitted to Department? Yes No <input checked="" type="checkbox"/> ; If yes, mo/day/yr sample was submitted		Water Well Disinfected? Yes <input checked="" type="checkbox"/> No	

5	TYPE OF BLANK CASING USED: 1 Steel 3 RMP (SR) <input checked="" type="checkbox"/> PVC 4 ABS	5 Wrought iron 8 Concrete tile 6 Asbestos-Cement 9 Other (specify below) 7 Fiberglass	CASING JOINTS: Glued <input checked="" type="checkbox"/> Clamped Welded Threaded
Blank casing diameter 16 in. to 35 ft., Dia in. to ft., Dia in. to ft.		Casing height above land surface 12 in., weight 16.15 lbs./ft. Wall thickness or gauge No. .500	
TYPE OF SCREEN OR PERFORATION MATERIAL: 1 Steel 3 Stainless Steel 5 Fiberglass 8 RMP (SR) 2 Brass 4 Galvanized Steel 6 Concrete tile 9 ABS 10 Asbestos-Cement 11 Other (Specify) 12 None used (open hole)		SCREEN OR PERFORATION OPENINGS ARE: 1 Continuous slot 3 Mill slot 5 Gauzed wrapped 8 Saw cut 11 None (open hole) 2 Louvered shutter 4 Key punched 6 Wire wrapped 9 Drilled holes 7 Torch cut 10 Other (specify)	
SCREEN-PERFORATED INTERVALS: From 35 ft. to 75 ft., From ft. to ft.		GRAVEL PACK INTERVALS: From 21 ft. to 75 ft., From ft. to ft.	

6	GROUT MATERIAL: 1 Neat cement <input checked="" type="checkbox"/> Cement grout 3 Bentonite 4 Other
Grout Intervals: From 1 ft. to 21 ft., From ft. to ft., From ft. to ft.	
What is the nearest source of possible contamination: None within 1/4 mile	
1 Septic tank 4 Lateral lines 7 Pit privy 10 Livestock pens 14 Abandoned water well	11 Fuel storage 15 Oil well/Gas well
2 Sewer lines 5 Cess pool 8 Sewage lagoon 12 Fertilizer storage 16 Other (specify below)	3 Watertight sewer lines 6 Seepage pit 9 Feedyard 13 Insecticide storage
Direction from well? How many feet?	

FROM	TO	LITHOLOGIC LOG	FROM	TO	PLUGGING INTERVALS
0	2	Sandy topsoil			
2	13	Clay, tan/sandy			
13	20	Sand- fine to medium			
20	49	Sand- fine to coarse/small gravel			
49	52	Clay, gray/sandy			
52	73	Sand- fine to coarse			
73	86	Clay, brown/gray with limestone rock			

7	CONTRACTOR'S OR LANDOWNER'S CERTIFICATION: This water well was <input checked="" type="checkbox"/> constructed, (2) reconstructed, or (3) plugged under my jurisdiction and was completed on (mo/day/year) 12/28/04 and this record is true to the best of my knowledge and belief. Kansas Water Well Contractor's Licence No 138 This Water Well Record was completed on (mo/day/yr) 12/30/04 under the business name of Peterson Irrigation, Inc. by (signature) <i>Mike Peterson</i>
---	---