

USE TYPEWRITER OR BALL POINT PEN-PRESS FIRMLY, PRINT CLEARLY.

WATER WELL RECORD
KSA 82a-1201-1215


Kansas Department of Health and Environment
Division of Environment
(Water well Contractors)
Topeka, Kansas 66620

Sangster #1

Plotted

1. Location of well: County Rice Fraction NW 1/4 NW 1/4 SW 1/4 Section number 11 Township number T 20 S Range number R 8 W E/W

2. Distance and direction from nearest town or city: 2 South
Street address of well location if in city: 2 1/2 east of Lyons
3. Owner of well: Dupe Drilling Co
R.R. or street:
City, state, zip code: Great Bend Kansas

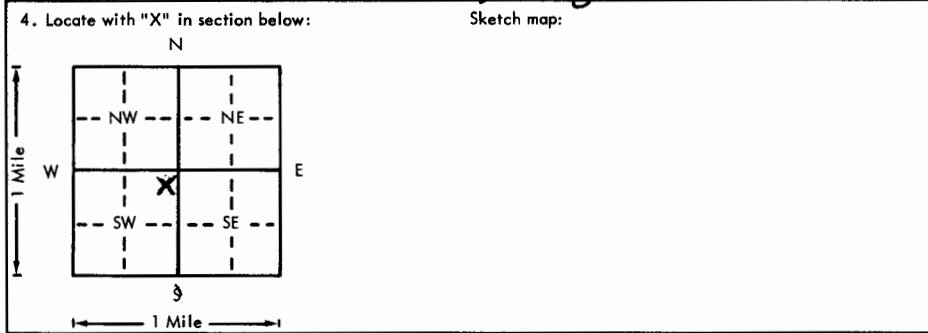

6. Bore hole dia. 7 in. Completion date 10-13-75
Well depth 60 ft.
7. Cable tool Rotary Driven Dug
 Hollow rod Jetted Bored Reverse rotary
8. Use: Domestic Public supply Industry
 Irrigation Air conditioning Stock
 Lawn Oil field water Other
9. Casing: Material PVC Height: (Above) or below
Threaded Welded Surface 12 in.
RMP PVC Weight 183 lbs per ft.
Dia. 4 in. to 60 ft. depth Wall Thickness: inches or
Dia. in. to ft. depth gage No. 200

5. Type and color of material

	From	To
<u>Clay</u>	<u>0</u>	<u>15</u>
<u>Sand</u>	<u>15</u>	<u>40</u>
<u>Gravel</u>	<u>40</u>	<u>60</u>

10. Screen: Manufacturer's name Perless Plastic
Type PVC Dia. 4
Slot/gauge 1/8 Length 20
Set between 40 ft. and 60 ft.
 ft. and ft.
Gravel pack? yes Size range of material 1/8 - 1/4
11. Static water level: 15 ft. below land surface Date 10-13-75 mo./day/yr.
12. Pumping level below land surfaces:
 ft. after hrs. pumping g.p.m.
 ft. after hrs. pumping g.p.m.
Estimated maximum yield g.p.m.
13. Water sample submitted: mo./day/yr.
 Yes No Date
14. Well head completion:
 Pitless adapter Inches above grade
15. Well grouted? yes
With: Neat cement Bentonite Concrete
Depth: From X ft. to X ft.
16. Nearest source of possible contamination:
ft. Direction Type
Well disinfected upon completion? Yes No
17. Pump: Not installed
Manufacturer's name
Model number HP Volts
Length of drop pipe ft. capacity g.p.m.
Type:
 Submersible Turbine
 Jet Reciprocating
 Centrifugal Other

18. Elevation: 1654
Topography: Hill
 Hill
 Slope
 Upland
 Valley
19. Remarks: 790

20. Water well contractor's certification:
This well was drilled under my jurisdiction and this report is true to the best of my knowledge and belief.
Myers Water Well 149
Business name Great Bend KS License No.
Address
Signed Date 10-13-75
Authorized representative

T 20 S
 R 8 W
 Sec 11 NW 1/4 SW 1/4