


1 LOCATION OF WATER WELL: County: Rece Fraction: NW 1/4 SW 1/4 SW 1/4 Section Number: 11 Township Number: T 20 S Range Number: R 8 E(11)

Distance and direction from nearest town or city street address of well if located within city?
1106' N 1/2 41'E of SW Cor Sec 10 and R-96

2 WATER WELL OWNER: KDHE
 RR#, St. Address, Box #: Forbes Field, Bldg 740
 City, State, ZIP Code: Topeka KS 66620-0001
 Board of Agriculture, Division of Water Resources
 Application Number:

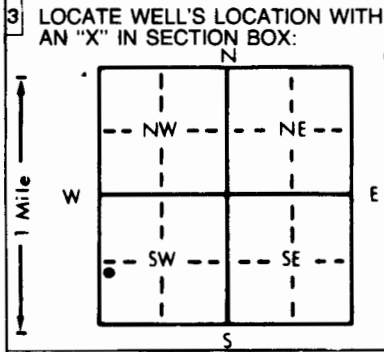

4 DEPTH OF COMPLETED WELL: 68 ft. ELEVATION: 1652.04 TC
 Depth(s) Groundwater Encountered 1. 18 ft. 2. _____ ft. 3. _____ ft.
 WELL'S STATIC WATER LEVEL: 15.88 ft. below land surface measured on mo/day/yr 10-23-95
 Pump test data: Well water was _____ ft. after _____ hours pumping _____ gpm
 Est. Yield _____ gpm Well water was _____ ft. after _____ hours pumping _____ gpm
 Bore Hole Diameter: 8 in. to _____ ft., and _____ in. to _____ ft.
 WELL WATER TO BE USED AS:
 5 Public water supply 8 Air conditioning 11 Injection well
 1 Domestic 3 Feedlot 6 Oil field water supply 9 Dewatering 12 Other (Specify below)
 2 Irrigation 4 Industrial 7 Lawn and garden only 10 Monitoring well
 Was a chemical/bacteriological sample submitted to Department? Yes _____ No X; If yes, mo/day/yr sample was submitted _____
 Water Well Disinfected? Yes _____ No X

5 TYPE OF BLANK CASING USED:
 1 Steel 3 RMP (SR) 5 Wrought iron 8 Concrete tile CASING JOINTS: Glued _____ Clamped _____
2 PVC 4 ABS 7 Fiberglass _____ Welded _____
 Blank casing diameter 2 in. to _____ ft., Dia _____ in. to _____ ft., Dia _____ in. to _____ ft.
 Casing height above land surface: Flush in., weight 703 lbs./ft. Wall thickness or gauge No. Sch 40
 TYPE OF SCREEN OR PERFORATION MATERIAL:
 1 Steel 3 Stainless steel 5 Fiberglass 8 RMP (SR) 10 Asbestos-cement 11 Other (specify) _____
 2 Brass 4 Galvanized steel 6 Concrete tile 9 ABS 12 None used (open hole)
 SCREEN OR PERFORATION OPENINGS ARE:
 1 Continuous slot 3 Mill slot 5 Gauzed wrapped 8 Saw cut 11 None (open hole)
 2 Louvered shutter 4 Key punched 6 Wire wrapped 9 Drilled holes
 7 Torch cut 10 Other (specify) _____
 SCREEN-PERFORATED INTERVALS: From 58 ft. to 68 ft., From _____ ft. to _____ ft.
 From _____ ft. to _____ ft., From _____ ft. to _____ ft.
 GRAVEL PACK INTERVALS: From 55 ft. to 68 ft., From _____ ft. to _____ ft.
 From _____ ft. to _____ ft., From _____ ft. to _____ ft.

6 GROUT MATERIAL: 1 Neat cement 2 Cement grout 3 Bentonite 4 Other
 Grout Intervals: From 25 ft. to 51.5 ft., From 51.5 ft. to 55 ft., From _____ ft. to _____ ft.
 What is the nearest source of possible contamination:
 1 Septic tank 4 Lateral lines 7 Pit privy 10 Livestock pens 14 Abandoned water well
 2 Sewer lines 5 Cess pool 8 Sewage lagoon 11 Fuel storage 15 Oil well/Gas well
 3 Watertight sewer lines 6 Seepage pit 9 Feedyard 12 Fertilizer storage 16 Other (specify below)
5th Mile
 13 Insecticide storage

Direction from well? _____ How many feet? _____

FROM	TO	LITHOLOGIC LOG	FROM	TO	PLUGGING INTERVALS
0	10	Clay			
10	13	Sand			
13	16	gravel, some sand			
16	66	Sand			
66	68	Shale			

7 CONTRACTOR'S OR LANDOWNER'S CERTIFICATION: This water well was 1 constructed, 2 reconstructed, or 3 plugged under my jurisdiction and was completed on (mo/day/year) 10-23-95 and this record is true to the best of my knowledge and belief. Kansas Water Well Contractor's License No. 531 This Water Well Record was completed on (mo/day/yr) 11-2-95 under the business name of GSI by (signature) Allison Turner