Darling Drilling Co.

Residence Phone 662-3991

1211 W. 4th
Hutchinson, Kansas 67501

Office Phone 662-7901

DRILLER'S TEST LOG

Customer's Name Steve Sellers Date Dec. 17, 1973

Address Lyons, Kans Test No.

County 3 south 1½ west Quarter Section 20 Township 20 Range 8

DRILLED FOOTAGE From	DRILLED FOOTAGE To	DESCRIPTION OF STRATA
0	2	soil
2	10	clay
10	15	sandy clay
15	45	sand - good
45	46	clay
46	66	sand - some clay ball
66	67	clay

Indicate Test Location By an X

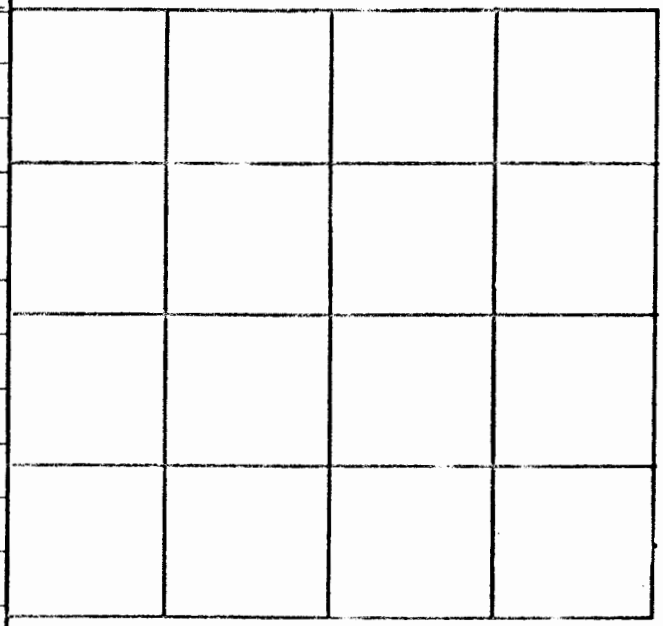

Static Water Level:

REMARKS: 850 GPM

Ed - driller