


1 LOCATION OF WATER WELL:	Fraction	Section Number	Township Number	Range Number
County: <u>Rice</u>	<u>SE 1/4 NW 1/4 SW 1/4</u>	<u>3</u>	<u>20</u>	<u>8</u> <span style="float:right;">E(W)</span>

Distance and direction from nearest town or city street address of well if located within city?  
 From the NE corner of Blair and Workman St. 35' S. 4' E GPS on data base 38.337704  
-98.197982  
Garman III GPS 38.33754  
by Scott Lang on 4-12-07 -98.19846

2 WATER WELL OWNER: <u>KDHE-BER (Project manager Doug Doubek)</u> <u>1000 SW Jackson (785-291-3246)</u>	Board of Agriculture, Division of Water Resources Application Number:
RR #, St. Address, Box #: City, State, ZIP Code : <u>Topeka, KS 66612-1367</u>	

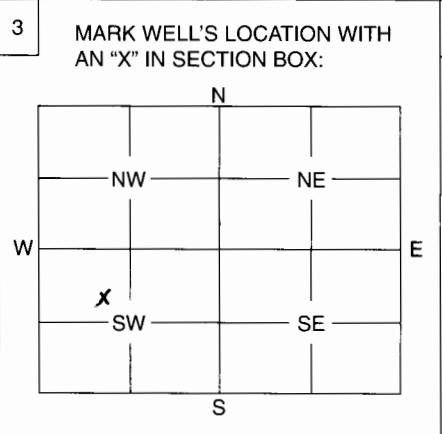

4 DEPTH OF WELL ..... 78.5 ..... ft. *original drilled depth*

WELL'S STATIC WATER LEVEL 36.95 ft.

On 4-12-07 well was measured. Well was silted in to -36" with 2" of water on top of the silt.

WELL WAS USED AS:

1 Domestic	5 Public Water Supply	9 Dewatering
2 Irrigation	6 Oil Field Water Supply	<u>10 Monitoring Well</u>
3 Feedlot	7 Domestic (Lawn & Garden)	11 Injection Well
4 Industrial	8 Air Conditioning	12 Other .....

Was a chemical / bacteriological sample submitted to Department? Yes ..... No X.....  
 If yes, mo/day/yr sample was submitted .....

Water Well Disinfected: Yes ..... No X.....

5 TYPE OF BLANK CASING USED:

1 Steel	3 RMP (SR)	5 Wrought	7 Fiberglass	9 Other (Specify below)
<u>2 PVC</u>	4 ABS	6 Asbestos-Cement	8 Concrete Tile	

Blank casing diameter 2 in. Was casing pulled? Yes ..... No X..... If yes, how much 18" below grade after filled with bentonite

Casing height above or below land surface ..... in.

6 GROUT PLUG MATERIAL: 1 Neat cement 2 Cement grout 3 Bentonite 4 Other .....

Grout Plug Intervals: From 0 ft. to 3 ft., From .....ft. to .....ft., From ..... to ..... ft.

What is the nearest source of possible contamination:

1 Septic tank	6 Seepage pit	11 Fuel storage	16 Other (specify below)
2 Sewer lines	7 Pit privy	12 Fertilizer storage	<u>Low level Chloride</u>
3 Watertight sewer lines	8 Sewage lagoon	13 Insecticide storage	<u>and VOC plumes</u>
4 Lateral lines	9 Feedyard	14 Abandoned water well	<u>exist in the vicinity</u>
5 Cess pool	10 Livestock pens	15 Oil well/Gas well	

Direction from well? ..... How many feet? .....

FROM	TO	PLUGGING MATERIALS
<u>0</u>	<u>3</u>	<u>Bentonite hole plug</u>
<u>3</u>	<u>78.5</u>	<u>suspect silt from surface runoff - The area where this well is has been cut to grade for a new road and is a low area. I suspect recent rains may have filled well with silt from the project.</u>

Upon arrival to plug the well, the casing was intact sticking up, pointed orange. The u-sult & pad had been removed. The J plug & tag were in place but the well had apparently been open at some point or some one had already filled it with sand or silt. From what I could tell, it appeared to be silt. The top 3' of the casing was still open. After consulting with Topeka it was decided that we should just fill the top 3' with bentonite and bust the casing off below grade

7 CONTRACTOR'S OF LANDOWNER'S CERTIFICATION: This water well was plugged under my jurisdiction and was completed on (mo/day/year) 4-12-07 and this record is true to the best of my knowledge and belief. Kansas Water Well Contractor's License No. .... This Water Well Record was completed on (mo/day/year) 4-17-07 under the business name of Ks. Dept. of Health + Environment by (signature) Scott Lang

INSTRUCTIONS: Use typewriter or ball point pen. Please press firmly and print clearly. Please fill in blanks, underline or circle the correct answers. Send top three copies to Kansas Department of Health and Environment, Bureau of Water, Geology Section, 1000 SW Jackson St., Ste. 420, Topeka, Kansas 66612-1367. Telephone: 785/296-5522. Send one to Water Well Owner and retain one for your records.