


WATER WELL RECORD Form WWC-5 KSA 82a-1212

| | | | | | | | | | |
|----------------------------|--|----------------|----------------|--|--|-----------------|--|--|--------------|
| 1] LOCATION OF WATER WELL: | | Fraction | Section Number | | | Township Number | | | Range Number |
| County: Rice | | NW ¼ NE ¼ NW ¼ | 9 | | | T 20 S | | | R 8 E/W |

Distance and direction from nearest town or city street address of well if located within city?
From Ave N & Hwy 14 go 3/4 mi W, on S side of road

2] WATER WELL OWNER: Lyons Salt Co.
 RR#, St. Address, Box # : 1660 Avenue N
 City, State, ZIP Code : Lyons, Kansas 67554
 Board of Agriculture, Division of Water Resources
 Application Number:

3] LOCATE WELL'S LOCATION WITH AN "X" IN SECTION BOX:

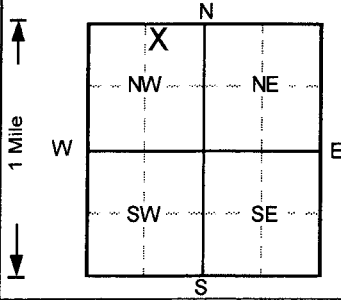

4] DEPTH OF COMPLETED WELL 25 ft. ELEVATION: 1664.68

Depth(s) Groundwater Encountered 1. ft 2. ft 3. ft

WELL'S STATIC WATER LEVEL . . . 16.5 . . . ft. below land surface measured on mo/day/yr . . . 10/2/2009

Pump test data: Well water was . . . NA . . . ft. after hours pumping gpm

Est. Yield . . NA . . gpm: Well water was ft. after hours pumping gpm

Bore Hole Diameter . . . 8 . . . in. to 25 ft., and in. to ft.

WELL WATER TO BE USED AS:

| | | |
|-----------------------|--------------------|--------------------------|
| 5 Public water supply | 8 Air conditioning | 11 Injection well |
| 1 Domestic | 3 Feedlot | 6 Oil field water supply |
| 2 Irrigation | 4 Industrial | 7 Lawn and garden only |
| | | 10 Monitoring well |
| | | 12 Other (Specify below) |

Was a chemical/bacteriological sample submitted to Department? Yes.....No ✓; If yes, mo/day/yr sample was submitted
 Water Well Disinfected? Yes No ✓

5] TYPE OF BLANK CASING USED:

| | | | | |
|---------|------------|-------------------|-------------------------|--|
| 1 Steel | 3 RMP (SR) | 5 Wrought iron | 8 Concrete tile | CASING JOINTS: Glued Clamped |
| 2 PVC | 4 ABS | 6 Asbestos-Cement | 9 Other (specify below) | Welded |
| | | 7 Fiberglass | | Threaded. ✓ |

Blank casing diameter 2 in. to 10 ft., Dia in. to ft., Dia in. to ft.

Casing height above land surface 22.3 in., weight lbs./ft. Wall thickness or gauge No. Sch. 40

TYPE OF SCREEN OR PERFORATION MATERIAL

| | | | | |
|---------|--------------------|-----------------|------------|--------------------------|
| 1 Steel | 3 Stainless steel | 5 Fiberglass | 8 RMP (SR) | 10 Asbestos-cement |
| 2 Brass | 4 Galvanized steel | 6 Concrete tile | 9 ABS | 11 Other (specify) |
| | | | | 12 None used (open hole) |

SCREEN OR PERFORATION OPENINGS ARE:

| | | | | |
|--------------------|---------------|------------------|--------------------|---------------------|
| 1 Continuous slot | 3 Mill slot | 5 Gauzed wrapped | 8 Saw cut | 11 None (open hole) |
| 2 Louvered shutter | 4 Key punched | 6 Wire wrapped | 9 Drilled holes | |
| | | 7 Torch cut | 10 Other (specify) | |

SCREEN-PERFORATED INTERVALS: From 10 ft. to 25 ft., From ft. to ft.

GRAVEL PACK INTERVALS: From 9 ft. to 25 ft., From ft. to ft.

6] GROUT MATERIAL: 1 Neat cement 2 Cement grout 3 Bentonite 4 Other

Grout intervals: From 0 ft. to 9 ft., From ft. to ft. to ft.

What is the nearest source of possible contamination:

| | | | | |
|--------------------------|-----------------|-----------------|------------------------|--------------------------|
| 1 Septic tank | 4 Lateral lines | 7 Pit privy | 10 Livestock pens | 14 Abandoned water well |
| 2 Sewer lines | 5 Cess pool | 8 Sewage lagoon | 11 Fuel storage | 15 Oil well/Gas well |
| 3 Watertight sewer lines | 6 Seepage pit | 9 Feedyard | 12 Fertilizer storage | 16 Other (specify below) |
| | | | 13 Insecticide storage | N/A |

Direction from well? How many feet?

| FROM | TO | LITHOLOGIC LOG | FROM | TO | PLUGGING INTERVALS |
|------|------|---------------------------|------|----|--------------------|
| 0 | 18.5 | Clay, silty, sandy, | | | |
| 18.5 | 25 | Clay, v. silty, v. sandy, | | | |
| | | | | | |
| | | | | | |
| | | | | | |
| | | | | | |
| | | | | | |
| | | | | | |
| | | | | | |
| | | | | | |
| | | | | | |
| | | | | | LSM-17P |
| | | | | | |
| | | | | | |

7] CONTRACTOR'S OR LANDOWNER'S CERTIFICATION: This water well was (1) constructed, (2) reconstructed, or (3) plugged under my jurisdiction and was completed on (mo/day/year) 1/17/2009 and this record is true to the best of my knowledge and belief.
 Kansas Water Well Contractor's License No. 527 This Water Well Record was completed on (mo/day/yr) 10/6/09 under the business name of **GeoCore, Inc.** by (signature) *Dale [Signature]*

INSTRUCTIONS: Use typewriter or ball point pen. PLEASE PRESS FIRMLY and PRINT clearly. Please fill in blanks, underline or circle the correct answers. Send top three copies to Kansas Department of Health and Environment, Bureau of Water, Topeka, Kansas 66620-0001. Telephone: 913-296-5545. Send one to WATER WELL OWNER and retain one for your records.

OFFICE USE ONLY
 T
 R
 EW
 SEC