


Revised

1 LOCATION OF WATER WELL: Fraction NE ¼ NW ¼ SE ¼ SW ¼ Section Number 9 Township Number T 20 S Range Number R 8 E/W

Distance and direction from nearest town or city street address of well if located within city?
 3/4 mile W of Grand & American, S into field

2 WATER WELL OWNER: Lyons Salt Co.
 RR#, St. Address, Box # : 1660 Avenue N
 City, State, ZIP Code : Lyons, Kansas 67554
 Board of Agriculture, Division of Water Resources
 Application Number:

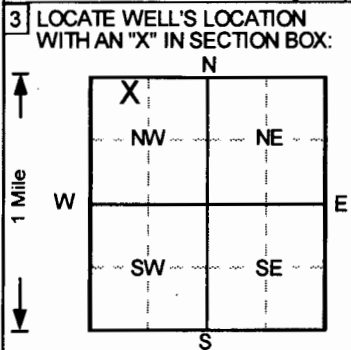

4 DEPTH OF COMPLETED WELL 500 ft ELEVATION 1662.4
 Depth(s) Groundwater Encountered 1. ft 2. ft 3. ft
 WELL'S STATIC WATER LEVEL 0 ft below land surface measured on mo/day/yr 10/2/2009
 Pump test data: Well water was NA ft after hours pumping gpm
 Est. Yield NA gpm: Well water was ft after hours pumping gpm
 Bore Hole Diameter 14 in. to 90 ft, and 10 in. to 220 ft
 WELL WATER TO BE USED AS: 5 Public water supply 8 Air conditioning 11 Injection well
 1 Domestic 3 Feedlot 6 Oil field water supply 9 Dewatering 12 Other (Specify below)
 2 Irrigation 4 Industrial 7 Lawn and garden only 10 Monitoring
 Was a chemical/bacteriological sample submitted to Department? Yes No ; If yes, mo/day/yr sample was submitted
 Water Well Disinfected? Yes No

5 TYPE OF BLANK CASING USED: 5 Wrought iron 8 Concrete tile CASING JOINTS: Glued Clamped
 1 Steel 3 RMP (SR) 6 Asbestos-Cement 9 Other (specify below) Welded
 2 PVC 4 ABS 7 Fiberglass Threaded.
 Blank casing diameter 10 in. to 90 ft, Dia 6 in. to 220 ft, Dia in. to ft
 Casing height above land surface 43.9 in., weight lbs./ft. Wall thickness or gauge No. Sch. 40
 TYPE OF SCREEN OR PERFORATION MATERIAL 7 PVC 10 Asbestos-cement
 1 Steel 3 Stainless steel 5 Fiberglass 8 RMP (SR) 11 Other (specify)
 2 Brass 4 Galvanized steel 6 Concrete tile 9 ABS 12 None used (open hole)
 SCREEN OR PERFORATION OPENINGS ARE: 5 Gauzed wrapped 8 Saw cut 11 None (open hole)
 1 Continuous slot 3 Mill slot 9 Drilled holes
 2 Louvered shutter 4 Key punched 7 Torch cut 10 Other (specify)
 SCREEN-PERFORATED INTERVALS: From Open Bore ft to 500 ft, From ft to ft
 From ft to ft, From ft to ft
 GRAVEL PACK INTERVALS: From ft to ft, From ft to ft
 From ft to ft, From ft to ft

6 GROUT MATERIAL: 1 Neat cement 2 Cement grout 3 Bentonite 4 Other
 Grout Intervals: From 0 ft to 90 ft, From 0 ft to 220 ft, From ft to ft
 What is the nearest source of possible contamination:
 1 Septic tank 4 Lateral lines 7 Pit privy 10 Livestock pens 14 Abandoned water well
 2 Sewer lines 5 Cess pool 8 Sewage lagoon 11 Fuel storage 15 Oil well/Gas well
 3 Watertight sewer lines 6 Seepage pit 9 Feedyard 12 Fertilizer storage 16 Other (specify below)
 N/A
 Direction from well? How many feet?

FROM	TO	LITHOLOGIC LOG	FROM	TO	PLUGGING INTERVALS
0	18.5	Silt, sandy,			
18.5	33.5	Sand, silty,			
33.5	48.5	Sand, clayey,			
48.5	79	Sand, gravelly,			
79	500	Shale,			
					5 3/4" bore hole 220-500'
					Well partially grouted by another company
					LSM-5-G

7 CONTRACTOR'S OR LANDOWNER'S CERTIFICATION: This water well was (1) constructed, (2) reconstructed, or (3) plugged under my jurisdiction and was completed on (mo/day/year) 8/23/2008 and this record is true to the best of my knowledge and belief.
 Kansas Water Well Contractor's License No. 527 This Water Well Record was completed on (mo/day/yr) Revised 9/22/14
 under the business name of GeoCore, Inc. by (signature) Dale A. Bell

OFFICE USE ONLY
 T
 R
 E
 W
 SEC.