


1 LOCATION OF WATER WELL: Fraction SE 1/4 NW 1/4 NW 1/4 Section Number 9 Township Number T 20 S Range Number R 8 E/W

Distance and direction from nearest town or city street address of well if located within city? From Ave N & Hwy 14 go 3/4 mi W, on S side of road

2 WATER WELL OWNER: Lyons Salt Co. RR#, St. Address, Box #: 1660 Avenue N City, State, ZIP Code: Lyons, Kansas 67554 Board of Agriculture, Division of Water Resources Application Number:

3 LOCATE WELL'S LOCATION WITH AN "X" IN SECTION BOX:

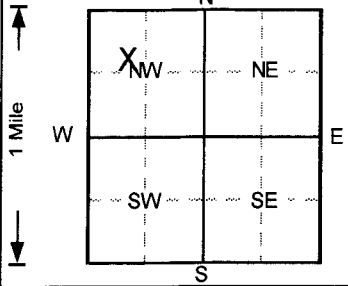

4 DEPTH OF COMPLETED WELL 20 ft ELEVATION: 1659.16 Depth(s) Groundwater Encountered 1. 5 ft 2. 5 ft 3. 5 ft WELL'S STATIC WATER LEVEL 5 ft below land surface measured on mo/day/yr 10/2/2009 Pump test data: Well water was NA ft. after NA hours pumping Est. Yield NA gpm: Well water was NA ft. after NA hours pumping Bore Hole Diameter 8 in. to 20 ft, and in. to in. WELL WATER TO BE USED AS: 5 Public water supply 8 Air conditioning 11 Injection well 1 Domestic 3 Feedlot 6 Oil field water supply 9 Dewatering 12 Other (Specify below) 2 Irrigation 4 Industrial 7 Lawn and garden only 10 Monitoring well Was a chemical/bacteriological sample submitted to Department? Yes No No; If yes, mo/day/yr sample was submitted Water Well Disinfected? Yes No

5 TYPE OF BLANK CASING USED: 1 Steel 2 PVC 3 RMP (SR) 4 ABS 5 Wrought iron 6 Asbestos-Cement 7 Fiberglass 8 Concrete tile 9 Other (specify below) CASING JOINTS: Glued Clamped Welded Threaded Blank casing diameter 2 in. to 10 ft, Dia in. to ft, Dia in. to ft Casing height above land surface 30.7 in., weight lbs./ft. Wall thickness or gauge No. Sch. 40 TYPE OF SCREEN OR PERFORATION MATERIAL: 1 Steel 2 Brass 3 Stainless steel 4 Galvanized steel 5 Fiberglass 6 Concrete tile 7 PVC 8 RMP (SR) 9 ABS 10 Asbestos-cement 11 Other (specify) 12 None used (open hole) SCREEN OR PERFORATION OPENINGS ARE: 1 Continuous slot 2 Louvered shutter 3 Mill slot 4 Key punched 5 Gauzed wrapped 6 Wire wrapped 7 Torch cut 8 Saw cut 9 Drilled holes 11 None (open hole) 10 Other (specify) SCREEN-PERFORATED INTERVALS: From 10 ft to 20 ft, From ft to ft GRAVEL PACK INTERVALS: From 9 ft to 20 ft, From ft to ft

6 GROUT MATERIAL: 1 Neat cement 2 Cement grout 3 Bentonite 4 Other Grout Intervals: From 0 ft to 9 ft, From ft to ft, From ft to ft What is the nearest source of possible contamination: 1 Septic tank 2 Sewer lines 3 Watertight sewer lines 4 Lateral lines 5 Cess pool 6 Seepage pit 7 Pit privy 8 Sewage lagoon 9 Feedyard 10 Livestock pens 11 Fuel storage 12 Fertilizer storage 13 Insecticide storage 14 Abandoned water well 15 Oil well/Gas well 16 Other (specify below) N/A Direction from well? How many feet?

Table with columns: FROM, TO, LITHOLOGIC LOG, FROM, TO, PLUGGING INTERVALS. Rows include lithologic logs: Silt, sandy; Sand, silty; and LSM-5P.

7 CONTRACTOR'S OR LANDOWNER'S CERTIFICATION: This water well was (1) constructed, (2) reconstructed, or (3) plugged under my jurisdiction and was completed on (mo/day/year) 1/16/2009 and this record is true to the best of my knowledge and belief. Kansas Water Well Contractor's License No. 527. This Water Well Record was completed on (mo/day/yr) 10/16/09 under the business name of GeoCore, Inc. by (signature)

OFFICE USE ONLY T R EM SEC. 1/4 1/4