


1 LOCATION OF WATER WELL: Fraction SE 1/4 NW 1/4 NW 1/4 Section Number 9 Township Number T 20 S Range Number R 8 E/W

Distance and direction from nearest town or city street address of well if located within city?

From Ave N & Hwy 14 go 3/4 mi W, on S side of road

2 WATER WELL OWNER: Lyons Salt Co. RR#, St. Address, Box #: 1660 Avenue N City, State, ZIP Code: Lyons, Kansas 67554 Board of Agriculture, Division of Water Resources Application Number:

3 LOCATE WELL'S LOCATION WITH AN "X" IN SECTION BOX:

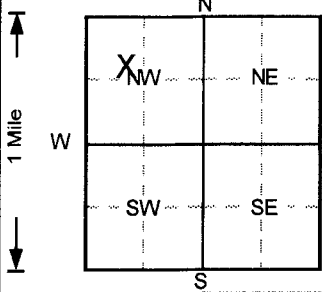

4 DEPTH OF COMPLETED WELL: 20 ft. ELEVATION: 1657.77. WELL'S STATIC WATER LEVEL: 3.9 ft. below land surface measured on 10/2/2009. Pump test data: Well water was NA ft. after NA hours pumping. Est. Yield: NA gpm. Bore Hole Diameter: 8 in. to 20 ft. WELL WATER TO BE USED AS: 10 Monitoring well. Was a chemical/bacteriological sample submitted to Department? Yes No. Water Well Disinfected? Yes No.

5 TYPE OF BLANK CASING USED: 2 PVC. Casing diameter: 2 in. to 10 ft. Casing height above land surface: 31.1 in. TYPE OF SCREEN OR PERFORATION MATERIAL: 7 PVC. SCREEN OR PERFORATION OPENINGS ARE: 3 Mill slot. SCREEN-PERFORATED INTERVALS: From 10 ft. to 20 ft. GRAVEL PACK INTERVALS: From 9 ft. to 20 ft.

6 GROUT MATERIAL: 3 Bentonite. Grout intervals: From 0 ft. to 9 ft. What is the nearest source of possible contamination: 16 Other (specify below). Direction from well? How many feet?

Table with 6 columns: FROM, TO, LITHOLOGIC LOG, FROM, TO, PLUGGING INTERVALS. Row 1: 0 to 18.5, Silt, sandy. Row 2: 18.5 to 20, Sand, silty. Row 3: LSM-6P.

7 CONTRACTOR'S OR LANDOWNER'S CERTIFICATION: This water well was (1) constructed, (2) reconstructed, or (3) plugged under my jurisdiction and was completed on 1/17/2009. Kansas Water Well Contractor's License No. 527. This Water Well Record was completed on 10/6/2009 under the business name of GeoCore, Inc. by (signature) Dale Hill.