


1 LOCATION OF WATER WELL: County: Rice Fraction: SE 1/4 NW 1/4 NW 1/4 Section Number: 9 Township Number: T 20 S Range Number: R 8 E/W

Distance and direction from nearest town or city street address of well if located within city? From Ave N & Hwy 14 go 3/4 mi W, on S side of road

2 WATER WELL OWNER: Lyons Salt Co. RR#, St. Address, Box #: 1660 Avenue N City, State, ZIP Code: Lyons, Kansas 67554 Board of Agriculture, Division of Water Resources Application Number:

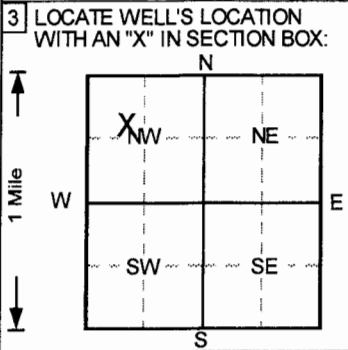

3 LOCATE WELL'S LOCATION WITH AN "X" IN SECTION BOX: 4 DEPTH OF COMPLETED WELL: 20 ft. ELEVATION: 1659.67. WELL'S STATIC WATER LEVEL: 9.4 ft below land surface. Pump test data: Well water was NA ft after NA hours pumping. Est. Yield NA gpm. Bore Hole Diameter: 8 in. to 20 ft. WELL WATER TO BE USED AS: 10 Monitoring well. Was a chemical/bacteriological sample submitted? No. Water Well Disinfected? No.

5 TYPE OF BLANK CASING USED: 2 PVC. Blank casing diameter: 2 in. Casing height above land surface: 24.1 in. TYPE OF SCREEN OR PERFORATION MATERIAL: 7 PVC. SCREEN OR PERFORATION OPENINGS ARE: 3 Mill slot. SCREEN-PERFORATED INTERVALS: From 10 ft to 20 ft. GRAVEL PACK INTERVALS: From 9 ft to 20 ft.

6 GROUT MATERIAL: 3 Bentonite. Grout intervals: From 0 ft to 9 ft. What is the nearest source of possible contamination: 16 Other (specify below) N/A. Direction from well?:

LITHOLOGIC LOG table with columns FROM, TO, LITHOLOGIC LOG, FROM, TO, PLUGGING INTERVALS. Entries include Silt, sandy (0-18.5) and Sand, silty (18.5-20). LSM-12P is noted at the bottom.

7 CONTRACTOR'S OR LANDOWNER'S CERTIFICATION: This water well was (1) constructed, (2) reconstructed, or (3) plugged under my jurisdiction and was completed on (mo/day/year) 1/17/2009 and this record is true to the best of my knowledge and belief. Kansas Water Well Contractor's License No. 527. This Water Well Record was completed on (mo/day/yr) 10/6/09 under the business name of GeoCore, Inc. by (signature) Dale Bell

OFFICE USE ONLY T R EM SEC. 1/4 1/4