

WATER WELL RECORD


Form WWC-5

Division of Water Resources App. No.

1 LOCATION OF WATER WELL: County: Rice, Fraction SE 1/4 SE 1/4 SE 1/4 NE 1/4, Section Number 7, Township No. T 20 S, Range Number R 8 E W

Street/Rural Address of Well Location; if unknown, distance & direction from nearest town or intersection: If at owner's address, check here [] From Lyons, 2 W. 1/4 S. Global Positioning System (GPS) information: Latitude: 38.32617, Longitude: 098.23839, Elevation: 1660

2 WATER WELL OWNER: Sellers Farms Inc. RR#, Street Address, Box #: 1420 Avenue N City, State, ZIP Code : Lvons, Kansas 67554 Collection Method: [x] GPS unit (Make/Model: Garmin csx), [] Digital Map/Photo, [x] Topographic Map, [] Land Survey Est. Accuracy: [] <3 m, [x] 3-5 m, [] 5-15 m, [] >15 m

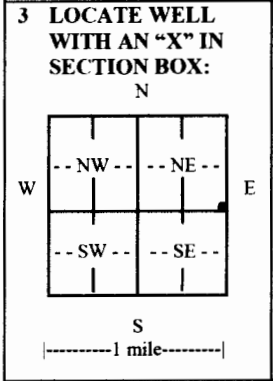

3 LOCATE WELL WITH AN "X" IN SECTION BOX: N, W, E, S, -----1 mile----- 4 DEPTH OF COMPLETED WELL 35 ft. Depth(s) Groundwater Encountered (1)..... ft. (2)..... ft. (3)..... ft. WELL'S STATIC WATER LEVEL 12 ft. below land surface measured on mo/day/yr. 6-27-2012 Pump test data: Well water was..... ft. after..... hours pumping..... gpm EST. YIELD..... gpm Well water was..... ft. after..... hours pumping..... gpm Bore Hole Diameter 6 1/2 in. to .35 ft., and..... in. to..... ft. WELL WATER TO BE USED AS: [] Public water supply [] Geothermal [] Injection well [] Domestic [] Feedlot [] Oil field water supply [] Dewatering [] Other (Specify below) [] Irrigation [] Industrial [] Domestic-lawn & garden [x] Monitoring well Was a chemical/bacteriological sample submitted to Department? [] Yes [x] No If yes, mo/day/yr sample was submitted..... Water well disinfected? [] Yes [x] No

5 TYPE OF CASING USED: [] Steel [x] PVC [] Other CASING JOINTS: [] Glued [] Clamped [] Welded [x] Threaded Casing diameter 2 in. to .20 ft., Diameter..... in. to..... ft., Diameter..... in. to..... ft. Casing height above land surface 36 in., Weight SCH 40 lbs./ft., Wall thickness or gauge No. 154 TYPE OF SCREEN OR PERFORATION MATERIAL: [] Steel [] Stainless Steel [x] PVC [] Other (Specify) [] Brass [] Galvanized Steel [] None used (open hole) SCREEN OR PERFORATION OPENINGS ARE: [] Continuous slot [] Mill slot [] Gauze wrapped [] Torch cut [] Drilled holes [] None (open hole) [] Louvered shutter [] Key punched [] Wire wrapped [x] Saw cut [] Other (specify) SCREEN-PERFORATED INTERVALS: From 20 ft. to 35 ft., From..... ft. to..... ft. From..... ft. to..... ft. GRAVEL PACK INTERVALS: From 35 ft. to 15 ft., From..... ft. to..... ft. From..... ft. to..... ft.

6 GROUT MATERIAL: [x] Neat cement [] Cement grout [x] Bentonite [] Other Grout Intervals: From 15 ft. to 12 ft., From 12 ft. to 0 ft., From..... ft. to..... ft. What is the nearest source of possible contamination: [] Septic tank [] Lateral lines [] Pit privy [x] Livestock pens [] Insecticide storage [] Other (specify below) [] Sewer lines [] Cesspool [] Sewage lagoon [] Fuel storage [] Abandoned water well [] Watertight sewer lines [] Seepage pit [] Feedyard [] Fertilizer storage [] Oil well/gas well Direction from well West Distance from well 400

Table with columns FROM, TO, LITHOLOGIC LOG, FROM, TO, LITHO. LOG (cont.) or PLUGGING INTERVALS. Rows include Top soil, Brown clay, Medium sand, Medium sand-yellow clay mix, Dark grey clay.

7 CONTRACTOR'S OR LANDOWNER'S CERTIFICATION: This water well was [x] constructed, [] reconstructed, or [] plugged under my jurisdiction and was completed on (mo/day/year) 6-27-2012 and this record is true to the best of my knowledge and belief. Kansas Water Well Contractor's License No. 134 This Water Well Record was completed on (mo/day/year) 7-6-2012 under the business name of Rosencrantz-Bemis Ent. by (signature) [Signature]

INSTRUCTIONS: Use typewriter or ball point pen. PLEASE PRESS FIRMLY and PRINT clearly. Please fill in blanks and check the correct answers. Send three copies (white, blue, pink) to Kansas Department of Health and Environment, Bureau of Water, Geology Section, 1000 SW Jackson St., Suite 420, Topeka, Kansas 66612-1367. Telephone 785-296-5524. Send one copy to WATER WELL OWNER and retain one for your records. Include fee of \$5.00 for each constructed well. Visit us at http://www.kdheks.gov/waterwell/index.html.