

CORRECTED


1 LOCATION OF WATER WELL:
County: Rice
Fraction: SE 1/4 NE 1/4 SE 1/4
Section Number: 15
Township Number: T 20 S
Range Number: R 8 EW

Distance and direction from nearest town or city street address of well if located within city?

1662 Avenue N, Lyons

2 WATER WELL OWNER: North American Salt
RR#, St. Address, Box #: 1660 Avenue N
City, State, ZIP Code: Lyons, KS 67554
Board of Agriculture, Division of Water Resources
Application Number:

3 LOCATE WELL'S LOCATION WITH AN 'X' IN SECTION BOX:

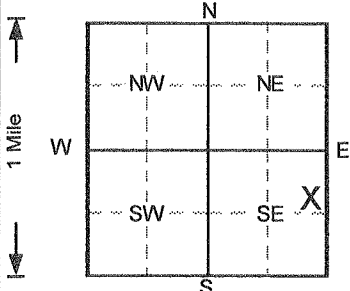

4 DEPTH OF COMPLETED WELL 56.5 ft. ELEVATION:

Depth(s) Groundwater Encountered 1. ft. 2. ft. 3. ft.
WELL'S STATIC WATER LEVEL ft. below land surface measured on mo/day/yr
Pump test data: Well water was ft. after hours pumping gpm
Est. Yield gpm: Well water was ft. after hours pumping gpm
Bore Hole Diameter 8 1/2 in. to 56.5 ft., and in. to ft.
WELL WATER TO BE USED AS: 5 Public water supply 8 Air conditioning 11 Injection well
1 Domestic 3 Feedlot 6 Oil field water supply 9 Dewatering 12 Other (Specify below)
2 Irrigation 4 Industrial 7 Lawn and garden only 10 Monitoring Well
Was a chemical/bacteriological sample submitted to Department? Yes.....No [checked]; If yes, mo/day/yr sample was submitted
Water Well Disinfected? Yes No [checked]

5 TYPE OF BLANK CASING USED:
1 Steel 2 PVC [circled] 3 RMP (SR) ABS [circled]
Blank casing diameter 2 1/4 in. to 46.5 ft, Dia in. to ft, Dia in. to ft
Casing height above land surface in., weight lbs./ft. Wall thickness or gauge No. Sch. 40
TYPE OF SCREEN OR PERFORATION MATERIAL
1 Steel 2 Brass 3 Stainless steel 4 Galvanized steel 5 Fiberglass 6 Concrete tile 7 PVC [circled] 8 RMP (SR) 9 ABS 10 Asbestos-cement 11 Other (specify) 12 None used (open hole)

SCREEN OR PERFORATION OPENINGS ARE:
1 Continuous slot 2 Louvered shutter 3 Mill slot [circled] 4 Key punched 5 Gauzed wrapped 6 Wire wrapped 7 Torch cut 8 Saw cut 9 Drilled holes 10 Other (specify) 11 None (open hole)
SCREEN-PERFORATED INTERVALS: From 46.5 ft to 56.5 ft, From ft to ft, From ft to ft, From ft to ft
GRAVEL PACK INTERVALS: From 44 ft to 56.5 ft, From ft to ft, From ft to ft, From ft to ft

6 GROUT MATERIAL: 1 Neat cement 2 Cement grout 3 Bentonite [circled] 4 Other Concrete [circled]
Grout Intervals: From 0 ft to 0.5 ft, From 0.5 ft to 44 ft, From ft to ft
What is the nearest source of possible contamination:
1 Septic tank 2 Sewer lines 3 Watertight sewer lines 4 Lateral lines 5 Cess pool 6 Seepage pit 7 Pit privy 8 Sewage lagoon 9 Feedyard 10 Livestock pens 11 Fuel storage 12 Fertilizer storage 13 Insecticide storage 14 Abandoned water well 15 Oil well/Gas well 16 Other (specify below)
Direction from well? How many feet?

Table with columns FROM, TO, LITHOLOGIC LOG, FROM, TO, PLUGGING INTERVALS. Rows include Topsoil (0-3), Clay, silty, Gray to Brown (3-15), Sand, coarse, some gravel, Lt. Brown (15-57), and MW-136D, Flushmount.

7 CONTRACTOR'S OR LANDOWNER'S CERTIFICATION: This water well was (1) constructed, (2) reconstructed, or (3) plugged under my jurisdiction and was completed on (mo/day/year) 6/3/2013 and this record is true to the best of my knowledge and belief.
Kansas Water Well Contractor's License No. 527 This Water Well Record was completed on (mo/day/yr) 6/21/13
under the business name of GeoCore, Inc. by (signature) [Signature] 6/21/13