

CORRECTED

WATER WELL RECORD Form WWC-5 KSA 82a-1212

Corrected

1 LOCATION OF WATER WELL: County: Rice	Fraction NW 1/4 NW 1/4 NE 1/4	Section Number 5	Township Number T 20 S	Range Number R 8 E/W
--	---	----------------------------	----------------------------------	--------------------------------


Distance and direction from nearest town or city street address of well if located within city?

1450 W. US Hwy 56, Lyons

2 WATER WELL OWNER: **City of Lyons**
 RR#, St. Address, Box # : **PO Box 808**
 City, State, ZIP Code : **Lyons, Kansas 67554**

Board of Agriculture, Division of Water Resources
Application Number:

3 LOCATE WELL'S LOCATION WITH AN "X" IN SECTION BOX:

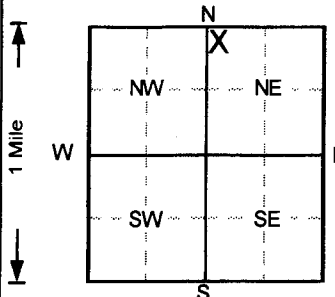

4 DEPTH OF COMPLETED WELL: **40** ft. ELEVATION: **1690.22**

Depth(s) Groundwater Encountered 1. ft. 2. ft. 3. ft.

WELL'S STATIC WATER LEVEL . . . **31.1** . . . ft. below land surface measured on **mo/day/yr** . . . **9/6/2013**

Pump test data: Well water was . . . **NA** . . . ft. after hours pumping gpm

Est. Yield . . **NA** . . . gpm: Well water was ft. after hours pumping gpm

Bore Hole Diameter . . . **8** . . . in. to **40** . . . ft., and in. to ft.

WELL WATER TO BE USED AS: 5 Public water supply 8 Air conditioning 11 Injection well
 1 Domestic 3 Feedlot 6 Oil field water supply 9 Dewatering 12 Other (Specify below)
 2 Irrigation 4 Industrial 7 Lawn and garden only **10 Monitoring well**

Was a chemical/bacteriological sample submitted to Department? Yes No ; If yes, mo/day/yr sample was submitted

Water Well Disinfected? Yes No

5 TYPE OF BLANK CASING USED:

1 Steel 3 RMP (SR) 5 Wrought iron 8 Concrete tile CASING JOINTS: Glued Clamped
 2 **PVC** 4 ABS 6 Asbestos-Cement 9 Other (specify below) Welded
 7 Fiberglass Threaded.

Blank casing diameter **2** . . . in. to **25** . . . ft., Dia in. to ft., Dia in. to ft.

Casing height above land surface **7.32** . . . in., weight lbs./ft. Wall thickness or gauge No. . . . **Sch. 40**

TYPE OF SCREEN OR PERFORATION MATERIAL

1 Steel 3 Stainless steel 5 Fiberglass **7** PVC 10 Asbestos-cement
 2 Brass 4 Galvanized steel 6 Concrete tile 8 RMP (SR) 11 Other (specify)
 12 None used (open hole)

SCREEN OR PERFORATION OPENINGS ARE:

1 Continuous slot **3** Mill slot 5 Gauzed wrapped 8 Saw cut 11 None (open hole)
 2 Louvered shutter 4 Key punched 6 Wire wrapped 9 Drilled holes
 7 Torch cut 10 Other (specify)

SCREEN-PERFORATED INTERVALS: From **25** . . . ft. to **40** . . . ft., From ft. to ft.
 From ft. to ft., From ft. to ft.

GRAVEL PACK INTERVALS: From **23** . . . ft. to **40** . . . ft., From ft. to ft.
 From ft. to ft., From ft. to ft.

6 GROUT MATERIAL: 1 Neat cement 2 Cement grout **3** Bentonite **4** Other **Concrete**

Grout Intervals: From **0** . . . ft. to **1** . . . ft., From **1** . . . ft. to **25** . . . ft., From ft. to ft.

What is the nearest source of possible contamination:

1 Septic tank 4 Lateral lines 7 Pit privy **10** Livestock pens 14 Abandoned water well
 2 Sewer lines 5 Cess pool 8 Sewage lagoon **11** Fuel storage 15 Oil well/Gas well
 3 Watertight sewer lines 6 Seepage pit 9 Feedyard 12 Fertilizer storage 16 Other (specify below)
 13 Insecticide storage

Direction from well? **NW** How many feet? **180**

FROM	TO	LITHOLOGIC LOG	FROM	TO	PLUGGING INTERVALS
0	1	Silt, Dark Brown			
1	5	Clay, sl. silty, Brown			
5	7	Clay, sl. silty, Gray Brown			
7	11	Clay, silty, Brown to Orange Brown			
11	17	Clay, silty, Orange Brown			
17	22	Clay, v. silty, Orange Brown to Brown			
22	27	Clay, silty, Orange Brown to Brown			
27	34	Clay, silty, Brown to Orange Brown			
34	40	Clay, silty, Orange Brown to Brown			
					MW9, Flushmount

7 CONTRACTOR'S OR LANDOWNER'S CERTIFICATION: This water well was **(1)** constructed, (2) reconstructed, or (3) plugged under my jurisdiction and was completed on (mo/day/year) **8/30/2013** and this record is true to the best of my knowledge and belief.
 Kansas Water Well Contractor's License No. **527**. This Water Well Record was completed on (mo/day/yr) **2/21/14**
 under the business name of **GeoCore, Inc.** by (signature) *Dale Kell*

INSTRUCTIONS: Use typewriter or ball point pen. PLEASE PRESS FIRMLY and PRINT clearly. Please fill in blanks, underline or circle the correct answers. Send top three copies to Kansas Department of Health and Environment, Bureau of Water, Topeka, Kansas 66620-0001. Telephone: 913-296-5545. Send one to WATER WELL OWNER and retain one for your records.

OFFICE USE ONLY

T

R

EW

SEC.

1/4

1/4

1/4