

WATER WELL PLUGGING RECORD Form WWC-5P KSA 82a-1212 ID NO.

MW12


1 LOCATION OF WATER WELL: Fraction NE 1/4 NE 1/4 NE 1/4 Section Number 4 Township Number T 20 S Range Number 8 E W
 County: RICE

Street/Rural Address of Well Location; if unknown, distance & direction from nearest town or intersection: If at owner's address, check here 100 S. GRAND AVE. LYONS, KS

Global Positioning Systems (GPS) information:
 Latitude: 38.34680 (in decimal degrees)
 Longitude: -98.20298 (in decimal degrees)
 Elevation: 1693.28
 Horizontal Datum: WGS84, NAD83, NAD27
 Collection Method:

2 WATER WELL OWNER: COASTAL MART 2515 RR#, St. Address, Box #: 2 N. NEVADA City, State ZIP Code: COLORADO SPRINGS, CO

GPS unit (Make/Model: _____)
 Digital Map/Photo, Topographic Map, Land Survey
 Est. Accuracy: < 3 m, 3-5 m, 5-15 m, > 15 m

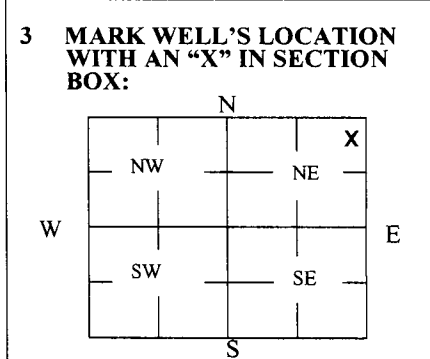

4 DEPTH OF WELL 70.83 ft.
 WELL'S STATIC WATER LEVEL 23.87 ft

WELL WAS USED AS:

Domestic Public Water Supply Dewatering
 Irrigation Oil Field Water Supply Monitoring
 Feedlot Domestic (Lawn & Garden) Injection Well
 Industrial Air Conditioning Other _____

Was a chemical/bacteriological sample submitted to Department? Yes No

5 TYPE OF BLANK CASING USED:

Steel RMP (SR) Wrought Fiberglass Other (Specify below)
 PVC ABS Asbestos-Cement Concrete Tile

Blank casing diameter 2 in. Was casing pulled? Yes No If yes, how much 3'
 Casing height above or below land surface _____ in.

6 GROUT PLUG MATERIAL: Neat cement Cement grout Bentonite Other CONCRETE 0-0.5

Grout Plug Intervals: From 0.5 ft. to 70.83 ft., From _____ ft. to _____ ft., From _____ ft. to _____ ft.

What is the nearest source of possible contamination:


Septic tank Seepage pit Fuel storage Other (specify below)
 Sewer lines Pit privy Fertilizer storage
 Watertight sewer lines Sewage lagoon Insecticide storage
 Lateral lines Feedyard Abandoned water well Direction from well? _____
 Cess pool Livestock pens Oil well/Gas well How many feet? _____

FROM	TO	PLUGGING MATERIALS	FROM	TO	PLUGGING MATERIALS
0	0.5	CONCRETE			
0.5	70.83	BENTONITE			

7 CONTRACTOR'S OR LANDOWNER'S CERTIFICATION: This water well was plugged under my jurisdiction and was completed on (mo/day/year) 5/13/21 and this record is true to the best of my knowledge and belief. Kansas Water Well Contractor's License No. 585. This Water Well Record was completed on (mo/day/year) 5/27/21 under the business name of ASSOCIATED ENVIRONMENTAL INC. by (signature)

Send one white copy to Kansas Department of Health & Environment, Geology Section, 1000 SW Jackson Street, Ste. 420, Topeka, KS 66612-1367. Send one copy to WATER WELL OWNER and retain one for your records.
 Visit us at <http://www.kdheks.gov/waterwell/index.html> Telephone 785-296-5524.

KSA82a-1212 Revised 1/20/2015

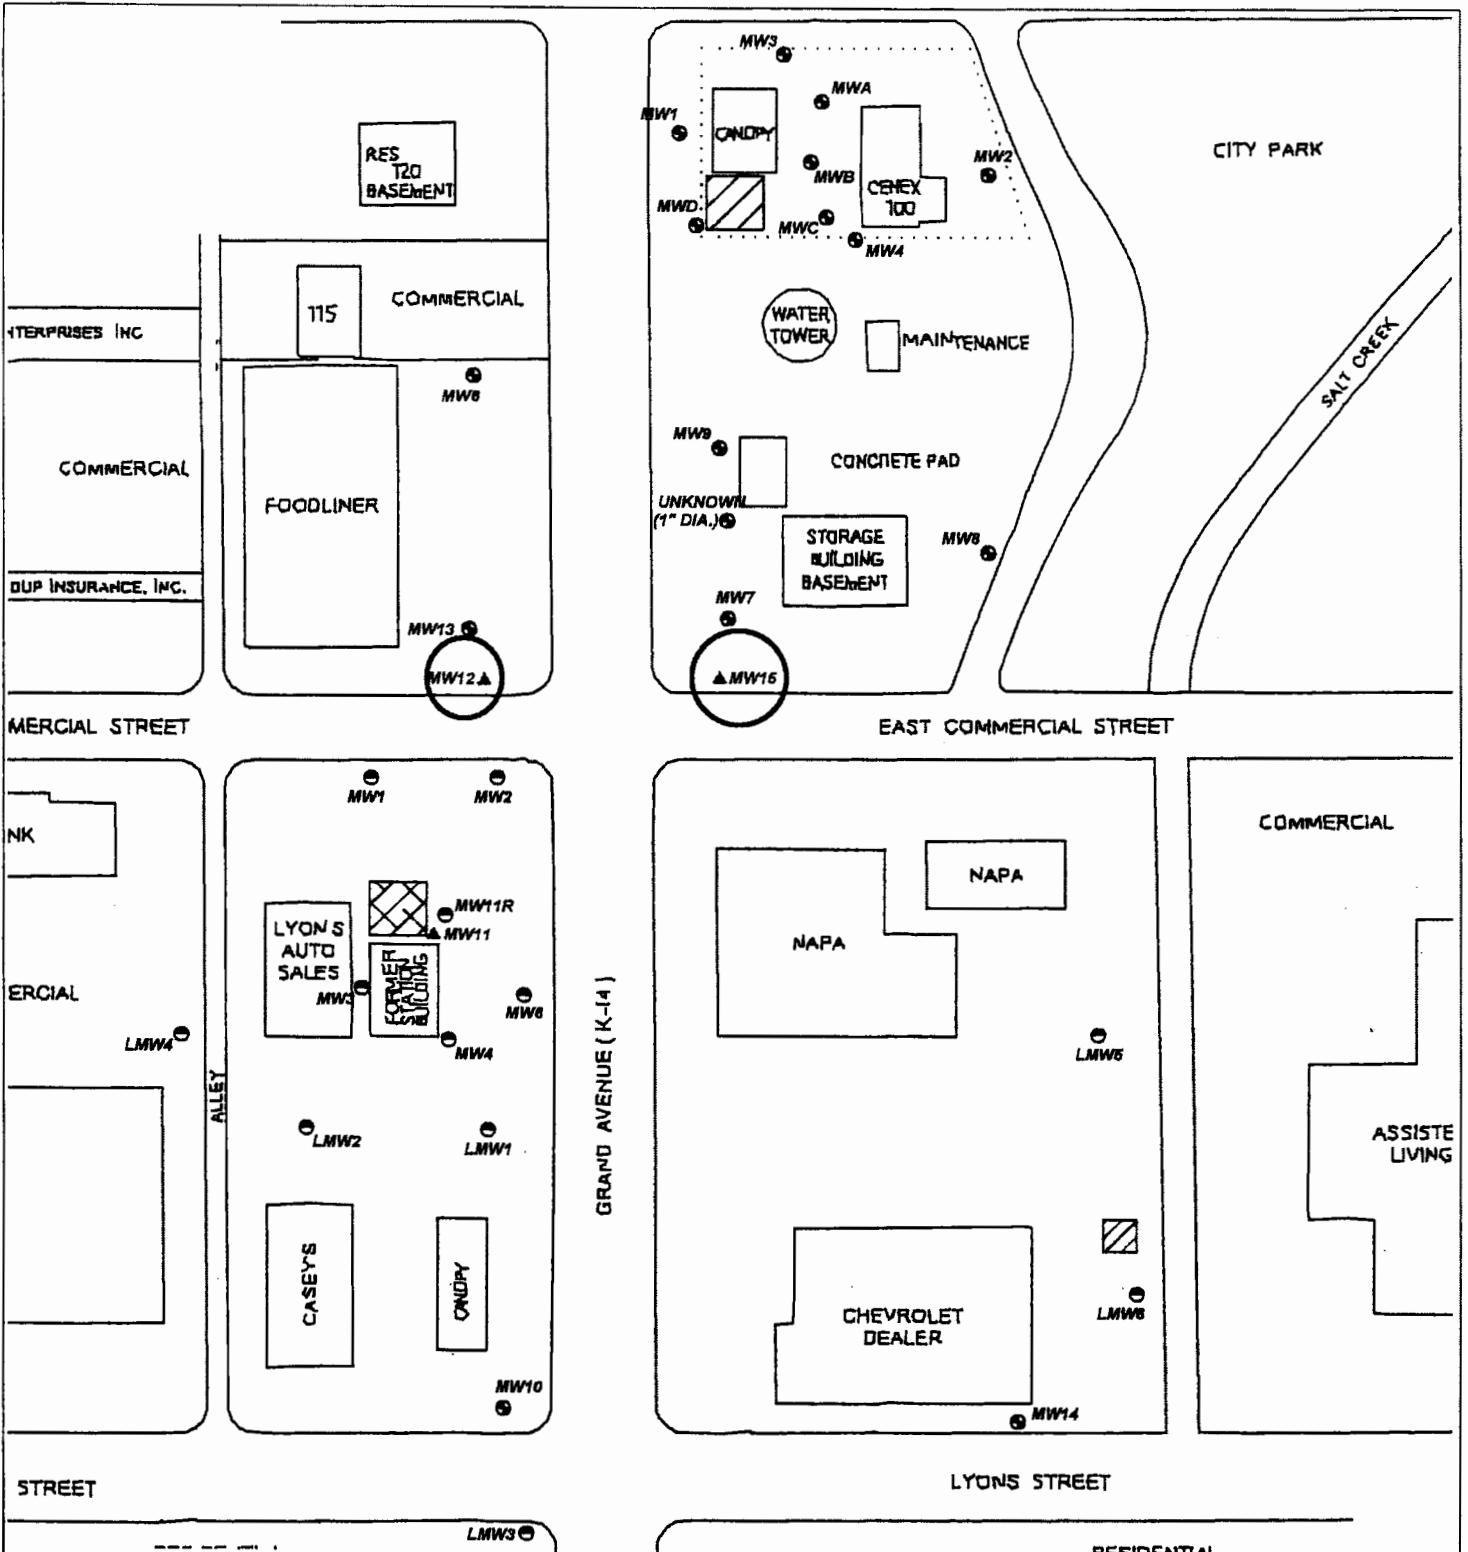

PROJECT: COASTAL MART #2515

ADDRESS: 100 S. GRAND

LOCATION: LYONS, KANSAS

DRAWN BY: C. ROE **DATE:** 4/30/21

REVISED BY: C. ROE **DATE:** 5/28/21

ADD JOB #: TF536 **PHONE JOB #:** U5-080-13053

SCALE: 1" = 100'

0 50 100

NOTES:

TITLE: AREA BASE MAP
350' RADIUS

ASSOCIATED ENVIRONMENTAL INC.

LEGEND:

- = ACTIVE USTS CURRENT CENEX/ FORMER COASTAL MART #2515
- = FORMER USTS FORMER L&M STATION & OTHER BASINS
- = MONITORING WELL [U5-080-13053] FORMER COASTAL MART #2515
- = MONITORING WELL [U5-080-14458] FORMER L&M STATION
- = PLUGGED/DESTROYED WELL
- = SUBJECT PROPERTY