

USE TYPEWRITER OR BALL POINT PEN-PRESS FIRMLY, PRINT CLEARLY.


WATER WELL RECORD  
KSA 82a-1201-1215

T R EW sec 1/4 1/4 1/4 No.

Kansas State Dept. Of Health  
(Water Well Contractors)  
Forbes-Bldg. 740  
Topeka, Kansas 66620

1 Location of well: County Rice Township name Atlanta Fraction SW 1/4 SW 1/4 Section number 2 Town number 2 OS. Range number 8 W.

Distance and direction from nearest town or city: 1 mile east and 1 mile south of Lyons, Kan.  
Street address of well location if in city: \_\_\_\_\_  
3 Owner of well: Phillips Line Co.  
Address: Lyons Kans R. 1.

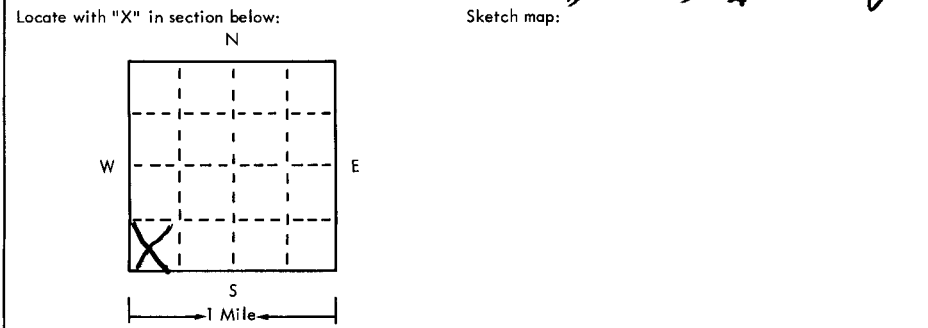

4 Well depth: 96 ft. Date of completion July 1975  
Well diameter 9 in.  
5  Cable tool  Rotary  Driven  Dug  
 Hollow rod  Jetted  Bored  Reverse rotary  
6 Use:  Domestic  Public supply  Industry  
 Irrigation  Air conditioning  Commercial  
 Test well  # summary  
7 Casing: Material plast Height: above/below  
Threaded  Welded  Surface 12 in.  
Dia. \_\_\_\_\_ Weight 4 lbs./ft. L  
6 in. to 90 ft. depth Drive shoe?  Yes  No  
\_\_\_\_\_ in. to \_\_\_\_\_ ft. depth

2	Type and color of material	From	To
	<u>Soil</u>	<u>1</u>	<u>3</u>
	<u>Brown clay</u>	<u>3</u>	<u>50</u>
	<u>Sandy clay</u>	<u>50</u>	<u>80</u>
	<u>Blue shale</u>	<u>80</u>	<u>90</u>
	<u>bedrock ?</u>		

8 Screen: Manufacturer contacted  
Type plast PVC Dia. 6 in.  
Slot/gauze 1/16 Length 40 ft.  
Set between 50 ft. and 90 ft.  
Fittings: Gravel pack  Yes  No Size range of material 1/4  
9 Static water level: 35 ft. below land surface Date 7-19-75  
10 Pumping level below land surfaces:  
\_\_\_\_\_ ft. after \_\_\_\_\_ hrs. pumping \_\_\_\_\_ g.p.m.  
\_\_\_\_\_ ft. after \_\_\_\_\_ hrs. pumping \_\_\_\_\_ g.p.m.  
Estimated maximum yield 30 g.p.m.  
11 Water sample submitted:  Yes  No Date \_\_\_\_\_  
12 Well head completion: 12 in.  
 Pitless adapter  Inches above grade  
13 Well grouted?  Yes  No  
 Neat cement  Bentonite  \_\_\_\_\_  
Depth: From 0 ft. to 16 ft.  
14 Nearest source of possible contamination: good water  
ft. 60 Direction North Type drilled  
Well disinfected upon completion?  Yes  No  
15 Pump:  Not installed  
Manufacturer's name \_\_\_\_\_  
Model number \_\_\_\_\_ HP \_\_\_\_\_ Volts \_\_\_\_\_  
Length of drop pipe \_\_\_\_\_ ft. capacity \_\_\_\_\_ g.m.p.  
Type:  Submersible  Turbine  
 Jet  Reciprocating  
 Centrifugal  Other

16 Remarks: elevation 1692 Topo  
old well casing rusted out and well plugged.  
Topography:  Hill  Slope  Upland  Valley

17 Water well contractor's certification:  
This well was drilled under my jurisdiction and this report is true to the best of my knowledge and belief.  
Arthur Varney 147  
Business name \_\_\_\_\_ License No. \_\_\_\_\_  
Address Lyons Kans. R. 1  
Signed Arthur Varney Date 7-17-75  
Authorized representative