

WATER WELL RECORD Form WWC-5 KSA 82a-1212


1 LOCATION OF WATER WELL: County: Rice Fraction: SE 1/4 SW 1/4 NW 1/4 Section Number: 4 Township Number: T 20 S Range Number: R 8 E(10)

Distance and direction from nearest town or city street address of well if located within city?
517 W Taylor, Lyons

2 WATER WELL OWNER: Larry Young
RR#, St. Address, Box #: 517 W Taylor Board of Agriculture, Division of Water Resources
City, State, ZIP Code: Lyons, KS 67554 Application Number:

3 LOCATE WELL'S LOCATION WITH AN "X" IN SECTION BOX:

4 DEPTH OF COMPLETED WELL: 82 ft. ELEVATION:

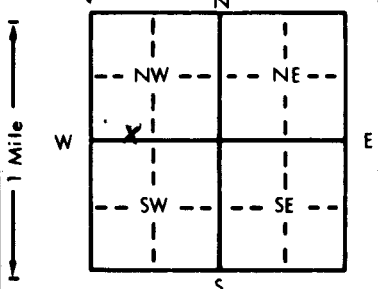

Depth(s) Groundwater Encountered 1. ft. 2. ft. 3. ft.
WELL'S STATIC WATER LEVEL: 4.5 ft. below land surface measured on mo/day/yr 4-9-86
Pump test data: Well water was 51 ft. after 2 hours pumping 30 gpm
Est. Yield: 40 gpm; Well water was _____ ft. after _____ hours pumping _____ gpm
Bore Hole Diameter: 9 in. to 8.4 in. to _____ in. to _____ ft.
WELL WATER TO BE USED AS:
1 Domestic 3 Feedlot 6 Oil field water supply 9 Dewatering 11 Injection well
2 Irrigation 4 Industrial 7 Lawn and garden only 10 Observation well
Was a chemical/bacteriological sample submitted to Department? Yes _____ No X; If yes, mo/day/yr sample was submitted _____
Water Well Disinfected? Yes X No

5 TYPE OF BLANK CASING USED:
1 Steel 3 RMP (SR) 5 Wrought iron 8 Concrete tile CASING JOINTS: Glued X Clamped _____
2 PVC 4 ABS 7 Fiberglass _____ Welded _____
Blank casing diameter: 6 in. to 7.2 in. Dia _____ in. to _____ in. Dia _____ in. to _____ ft.
Casing height above land surface: 12 in., weight 3.35 lbs./ft. Wall thickness or gauge No. 16.0

TYPE OF SCREEN OR PERFORATION MATERIAL:
1 Steel 3 Stainless steel 5 Fiberglass 8 RMP (SR) 10 Asbestos-cement
2 Brass 4 Galvanized steel 6 Concrete tile 9 ABS 11 Other (specify) _____
12 None used (open hole)

SCREEN OR PERFORATION OPENINGS ARE:
1 Continuous slot 3 Mill slot 5 Gauzed wrapped 8 Saw cut 11 None (open hole)
2 Louvered shutter 4 Key punched 6 Wire wrapped 9 Drilled holes
7 Torch cut 10 Other (specify) _____

SCREEN-PERFORATED INTERVALS: From 7.2 ft. to 82 ft., From _____ ft. to _____ ft.
From _____ ft. to _____ ft., From _____ ft. to _____ ft.
GRAVEL PACK INTERVALS: From 6.5 ft. to 8.4 ft., From _____ ft. to _____ ft.
From _____ ft. to _____ ft., From _____ ft. to _____ ft.

6 GROUT MATERIAL: 1 Neat cement 2 Cement grout 3 Bentonite 4 Other _____
Grout Intervals: From 3 ft. to 13 ft., From _____ ft. to _____ ft., From _____ ft. to _____ ft.

What is the nearest source of possible contamination:
1 Septic tank 4 Lateral lines 7 Pit privy 10 Livestock pens 14 Abandoned water well
2 Sewer lines 5 Cess pool 8 Sewage lagoon 11 Fuel storage 15 Oil well/Gas well
3 Watertight sewer lines 6 Seepage pit 9 Feedyard 12 Fertilizer storage 16 Other (specify below)
13 Insecticide storage _____
Direction from well? 40 E How many feet? 40

| FROM | TO | LITHOLOGIC LOG | FROM | TO | LITHOLOGIC LOG |
|------|----|------------------|------|----|----------------|
| 0 | 53 | Br Clay | | | |
| 53 | 62 | Sand | | | |
| 62 | 69 | Br Clay | | | |
| 69 | 83 | Sand + sm Gravel | | | |
| 83 | 84 | Br Clay | | | |

7 CONTRACTOR'S OR LANDOWNER'S CERTIFICATION: This water well was 1 constructed, (2) reconstructed, or (3) plugged under my jurisdiction and was completed on (mo/day/year) 4-9-86 and this record is true to the best of my knowledge and belief. Kansas Water Well Contractor's License No. 447 This Water Well Record was completed on (mo/day/yr) 6-29-86 under the business name of Miller Drilling by (signature) Gene Miller

INSTRUCTIONS: Use typewriter or ball point pen, PLEASE PRESS FIRMLY and PRINT clearly. Please fill in blanks, underline or circle the correct answers. Send top three copies to Kansas Department of Health and Environment, Division of Environment, Environmental Geology Section, Topeka, KS 66620. Send one to WATER WELL OWNER and retain one for your records.