

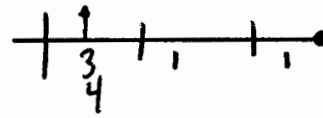
USE TYPEWRITER OR BALL POINT PEN—PRESS FIRMLY, PRINT CLEARLY.

WATER WELL RECORD
KSA 82a-1201-1215

Kansas Department of Health and Environment—Division of Environment
(Water well Contractors)
Topeka, Kansas 66620

Plotted

000

1. Location of well:	County Rice	Fraction SW 1/4 SW 1/4 SW 1/4	Section number 6	Township number T 20 S R 8 E W	Range number 8
2. Distance and direction from nearest town or city: Street address of well location if in city:	2 3/4 west of Lyons, Mo Rel.		3. Owner of well: R.R. or street: City, state, zip code:		
4. Locate with "X" in section below: N W E S 1 Mile			Sketch map: 		6. Bore hole dia. 26 in. Completion date 7/30/77 Well depth 91 ft. 7. Cable tool <input type="checkbox"/> Rotary <input type="checkbox"/> Driven <input type="checkbox"/> Dug <input type="checkbox"/> Hollow rod <input type="checkbox"/> Jetted <input type="checkbox"/> Bored <input checked="" type="checkbox"/> Reverse rotary 8. Use: <input type="checkbox"/> Domestic <input type="checkbox"/> Public supply <input type="checkbox"/> Industry <input checked="" type="checkbox"/> Irrigation <input type="checkbox"/> Air conditioning <input type="checkbox"/> Stock <input type="checkbox"/> Lawn <input type="checkbox"/> Oil field water <input type="checkbox"/> Other 9. Casing: Material Transite Height: Above or below Threaded <input type="checkbox"/> Welded <input checked="" type="checkbox"/> Surface 3 1/2 in. RMP <input type="checkbox"/> PVC <input type="checkbox"/> Weight 30 lbs./ft. Dia. 16 in. to 64 ft. depth Wall Thickness: inches or Dia. 0 in. to 64 ft. depth Gauge No. 3A
5. Type and color of material			From To		
Brown clay			0 20		
Sandy clay			20 25		
Sand w/little clay			25 30		
Mod. gravel			30 50		
Clay w/little sand			50 55		
Gravel w/ little clay			55 65		
Gravel, good			65 91		
X Clay			91 98		
10. Screen: Manufacturer's name			Johnson		
Type			sawed Dia. 16		
Slot/gauze			3/16 Length 26		
Set between			26 ft. and 90 ft.		
Gravel pack?			yes Size range of material 1/8 - 1/4		
11. Static water level:			mo./day/yr. 36 ft. below land surface Date 7/30/77		
12. Pumping level below land surfaces:			59 ft. after 1 hrs. pumping 750 g.p.m.		
			67 ft. after 2 hrs. pumping 1000 g.p.m.		
Estimated maximum yield			_____ g.p.m.		
13. Water sample submitted:			mo./day/yr. <input checked="" type="checkbox"/> Yes <input type="checkbox"/> No Date _____		
14. Well head completion:			<input type="checkbox"/> Pitless adapter 8 inches above grade		
15. Well grouted? yes			With: <input type="checkbox"/> Neat cement <input type="checkbox"/> Bentonite <input checked="" type="checkbox"/> Concrete Depth: From 0 ft. to 10 ft.		
16. Nearest source of possible contamination:			ft. _____ Direction None Type _____ Well disinfected upon completion? <input type="checkbox"/> Yes <input checked="" type="checkbox"/> No		
17. Pump:			Not installed Manufacturer's name Peerless Model number 450cc 12L 60 Volts 460 Length of drop pipe 70 ft. capacity 900 g.p.m. Type: <input type="checkbox"/> Submersible <input checked="" type="checkbox"/> Turbine <input type="checkbox"/> Jet <input type="checkbox"/> Reciprocating <input type="checkbox"/> Centrifugal <input type="checkbox"/> Other		
(Use a second sheet if needed)					
18. Elevation: 1691		19. Remarks: Topo			
Topography: <input type="checkbox"/> Hill <input type="checkbox"/> Slope <input checked="" type="checkbox"/> Upland <input type="checkbox"/> Valley		20. Water well contractor's certification: This well was drilled under my jurisdiction and this report is true to the best of my knowledge and belief. Darling Drilling Co. 189 Business name License No. Address 21 W. 4th Hutchinson, Kans Signed Donald Darling Authorized representative			

20
 W
 Sec
 6 SW 1/4 SW 1/4
 1/4 1/4