

USE TYPEWRITER OR BALL POINT PEN-PRESS FIRMLY, PRINT CLEARLY.


T R EW sec 1/4 1/4 1/4 No.

WATER WELL RECORD  
KSA 82a-1201-1215

Kansas State Dept. Of Health  
(Water Well Contractors)  
Forbes-Bldg. 740  
Topeka, Kansas 66620

1 Location of well: County Rice Township name Atlanta Fraction SW/34 NW/4 Section number 7 Town number 20 Range number 8 W

Distance and direction from nearest town or city: 1 mile south of Lyons 3 west 1/2 S0 3 Owner of well: Steve Reed  
Street address of well location if in city: Lyons, Kansas 67554 Address:

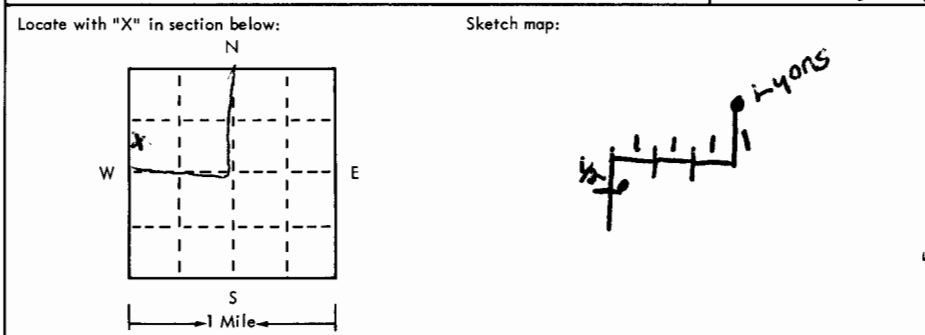

4 Well depth: 52 ft. Date of completion 10/6/78  
Well diameter 26 in.  
5  Cable tool  Rotary  Driven  Dug  
 Hollow rod  Jetted  Bored  Reverse rotary  
6 Use:  Domestic  Public supply  Industry  
 Irrigation  Air conditioning  Commercial  
 Test well  
7 Casing: Material Transite Height: 12 above/below  
Threaded  Welded  Surface 16 in.  
Dia. 16 Weight 30 lbs./ft.  
16 in. to 0 ft. depth Drive shoe?  Yes  No  
16 in. to 26 ft. depth

2	Type and color of material	From	To
	Top Soil	0	3
	Black clay	3	21
	Med. gravel	21	26
	Med. sand and clay	26	30
	Med. gravel	30	42
	Med. sand with clay spots	42	45
	Med. sand with clay	45	51
	Clay	51	58
	Bedrock ?		
	(use a second sheet if needed)		

8 Screen: Johnson  
Manufacturer Johnson  
Type Sawed Dia. 16"  
Slot/gauze 3/16 Length 26"  
Set between 26 ft. and 52 ft.  
Fittings:  
Gravel pack  Yes  No Size range of material 1/8 - 1/4

9 Static water level: 14 ft. below land surface Date 10-6-78

10 Pumping level below land surfaces:  
37 ft. after 1 hrs. pumping 700 g.p.m.  
39 ft. after 2 hrs. pumping 800 g.p.m.  
Estimated maximum yield 600 g.p.m. 800

11 Water sample submitted:  
 Yes  No Date \_\_\_\_\_

12 Well head completion:  
 Pitless adapter 12 inches above grade

13 Well grouted?  Yes  No  
 Neat cement  Bentonite  concrete  
Depth: From 0 ft. to 10 ft.

14 Nearest source of possible contamination:  
ft. \_\_\_\_\_ Direction none Type \_\_\_\_\_  
Well disinfected upon completion?  Yes  No

15 Pump:  Not installed  
Manufacturer's name Western Land Roller  
Model number 25000020 Volts 220  
Length of drop pipe 40 ft. capacity 625 g.m.p.  
Type:  
 Submersible  Turbine  
 Jet  Reciprocating  
 Centrifugal  Other

16 Remarks: elevation 1667 Topo flu  
Topography:  
 Hill  
 Slope  
 Upland  
 Valley

17 Water well contractor's certification:  
This well was drilled under my jurisdiction and this report is true to the best of my knowledge and belief.  
Rosenkrantz-Bemis, Inc.  
Business name License No. 134  
Address 201 W. 4th Hutchinson, Kans.  
Signed Donath J. Dahn 15-20-79  
Authorized representative

T205 R8W Sec 31 SW