


1 LOCATION OF WATER WELL: County: **Rice** Fraction: **SW 1/4 NW 1/4 NE 1/4** Section Number: **10** Township Number: **T 20 S** Range Number: **R 8W E/W**

Distance and direction from nearest town or city street address of well if located within city?
1/2 mile south Lyons, Ks.

2 WATER WELL OWNER: **American Salt Co.** Monitor well No. **84-17**
 RR#, St. Address, Box #: **Box 498** Board of Agriculture, Division of Water Resources
 City, State, ZIP Code: **Lyons, Ks. 67554** Application Number:

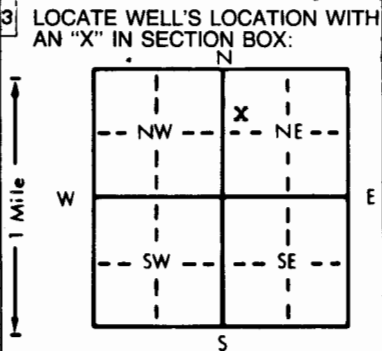

4 DEPTH OF COMPLETED WELL: **71** ft. ELEVATION: ft.
 Depth(s) Groundwater Encountered 1. **29** ft. 2. ft. 3. ft.
 WELL'S STATIC WATER LEVEL: **27.7** ft. below land surface measured on mo/day/yr **9/14/84**
 Pump test data: Well water was **ND** ft. after hours pumping gpm
 Est. Yield **ND** gpm: Well water was ft. after hours pumping gpm
 Bore Hole Diameter: in. to ft., and in. to ft.
 WELL WATER TO BE USED AS: 5 Public water supply 8 Air conditioning 11 Injection well
 1 Domestic 3 Feedlot 6 Oil field water supply 9 Dewatering 12 Other (Specify below)
 2 Irrigation 4 Industrial 7 Lawn and garden only 10 Observation well
 Was a chemical/bacteriological sample submitted to Department? Yes No **X**; If yes, mo/day/yr sample was submitted
 Water Well Disinfected? Yes No **X**

5 TYPE OF BLANK CASING USED: 1 Steel 2 PVC 3 RMP (SR) 4 ABS 5 Wrought iron 6 Asbestos-Cement 7 Fiberglass 8 Concrete tile 9 Other (specify below) CASING JOINTS: Glued Clamped Welded Threaded
 Blank casing diameter: **2** in. to **66** ft., Dia in. to ft., Dia in. to ft.
 Casing height above land surface: **18** in., weight lbs./ft. Wall thickness or gauge No. **SDR 26**
 TYPE OF SCREEN OR PERFORATION MATERIAL: 1 Steel 2 Brass 3 Stainless steel 4 Galvanized steel 5 Fiberglass 6 Concrete tile 7 PVC 8 RMP (SR) 9 ABS 10 Asbestos-cement 11 Other (specify) 12 None used (open hole)
 SCREEN OR PERFORATION OPENINGS ARE: 1 Continuous slot 2 Louvered shutter 3 Mill slot 4 Key punched 5 Gauzed wrapped 6 Wire wrapped 7 Torch cut 8 Saw cut 9 Drilled holes 11 None (open hole)
 SCREEN-PERFORATED INTERVALS: From **66** ft. to **71** ft., From ft. to ft.
 GRAVEL PACK INTERVALS: From **50** ft. to **71** ft., From ft. to ft.

6 GROUT MATERIAL: 1 Neat cement 2 Cement grout 3 Bentonite 4 Other
 Grout Intervals: From **0** ft. to **10** ft., From ft. to ft., From ft. to ft.
 What is the nearest source of possible contamination? **ND** 10 Livestock pens 14 Abandoned water well
 1 Septic tank 4 Lateral lines 7 Pit privy 11 Fuel storage 15 Oil well/Gas well
 2 Sewer lines 5 Cess pool 8 Sewage lagoon 12 Fertilizer storage 16 Other (specify below)
 3 Watertight sewer lines 6 Seepage pit 9 Feedyard 13 Insecticide storage
 Direction from well? How many feet?

FROM	TO	LITHOLOGIC LOG	FROM	TO	LITHOLOGIC LOG
0	22.5	Silt and clay			
22.5	23	Gravel and sand			
23	29	Silt			
29	33	Silt and sand interbedded			
33	42	Clay			
42	53	Gravel and sand			
53	58	Clay, light gray			
58	70	Gravel, sand and clay			
70	71	Shale, red and gray			

7 CONTRACTOR'S OR LANDOWNER'S CERTIFICATION: This water well was (1) constructed, (2) reconstructed, or (3) plugged under my jurisdiction and was completed on (mo/day/year) **0/14/84** and this record is true to the best of my knowledge and belief. Kansas Water Well Contractor's License No. **126** This Water Well Record was completed on (mo/day/yr) **9/30/84** under the business name of **Hydraulic Drilling Co.** by (signature) *[Signature]*

INSTRUCTIONS: Use typewriter or ball point pen, PLEASE PRESS FIRMLY and PRINT clearly. Please fill in blanks, underline or circle the correct answers. Send top three copies to Kansas Department of Health and Environment, Division of Environment, Environmental Geology Section, Topeka, KS 66620. Send one to WATER WELL OWNER and retain one for your records.

OFFICE USE ONLY

T

R

E/W

SEC.

1/4

1/4

1/4

1/4

1/4

1/4