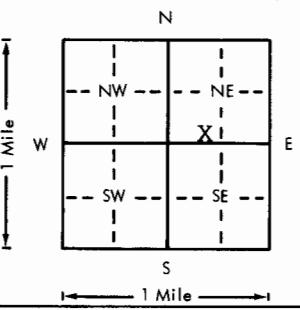


USE TYPEWRITER OR BALL POINT PEN-PRESS FIRMLY, PRINT CLEARLY.

WATER WELL RECORD  
KSA 82a-1201-1215

Kansas Department of Health and Environment-Division of Environment  
(Water well Contractors)  
Topeka, Kansas 66620

1. Location of well:	County <b>Rice</b>	Fraction <b>SE 1/4 SW 1/4 NE 1/4</b>	Section number <b>14</b>	Township number <b>T 20 S R 8 E W</b>	Range number <b>8</b>
2. Distance and direction from nearest town or city: <b>3 miles Southeast of Lyons, KS</b> Street address of well location if in city:			3. Owner of well: <b>Cecil Miller etal*</b> R.R. or street: <b>Route 1</b> City, state, zip code: <b>Lyons, KS 67554</b>		
4. Locate with "X" in section below: Sketch map:  <b>Test Well No. 13</b> <b>1550' West - 2640' South of NE Corner Sec. 14</b>			6. Bore hole dia. <u>5</u> in. Completion date <u>12/28/77</u> Well depth <u>66</u> ft.		
5. Type and color of material			7. <input checked="" type="checkbox"/> Cable tool <input checked="" type="checkbox"/> Rotary <input type="checkbox"/> Driven <input type="checkbox"/> Dug <input type="checkbox"/> Hollow rod <input type="checkbox"/> Jetted <input type="checkbox"/> Bored <input type="checkbox"/> Reverse rotary		
			8. Use: <input type="checkbox"/> Domestic <input type="checkbox"/> Public supply <input type="checkbox"/> Industry <input type="checkbox"/> Irrigation <input type="checkbox"/> Air conditioning <input type="checkbox"/> Stock <input type="checkbox"/> Lawn <input type="checkbox"/> Oil field water <input checked="" type="checkbox"/> Other <b>Test Well</b>		
From To			9. Casing: Material <u>PVC</u> Height: <u>Above</u> or below Threaded <input type="checkbox"/> Welded <input type="checkbox"/> Surface <input type="checkbox"/> in. RMP <input type="checkbox"/> PVC <input checked="" type="checkbox"/> Weight <u>.631</u> lbs./ft. Dia. <u>2 1/2</u> in. to <u>56</u> ft. depth Wall Thickness: inches or Dia. <input type="checkbox"/> in. to <input type="checkbox"/> ft. depth gage No. <u>.110</u>		
			10. Screen: Manufacturer's name <u>Clarke</u> Type <u>PVC</u> Dia. <u>2 1/2</u> " <input checked="" type="checkbox"/> Slot gauge <u>1/8"</u> Length <u>10</u> " Set between <u>56</u> ft. and <u>66</u> ft. <input type="checkbox"/> ft. and <input type="checkbox"/> ft. Gravel pack? <input checked="" type="checkbox"/> yes Size range of material <u>1/4"</u>		
Top Soil			11. Static water level: <u>17.2</u> ft. below land surface Date <u>3-17-78</u> mo./day/yr.		
Brown and Gray Clay			12. Pumping level below land surfaces: <u>NC</u> <input type="checkbox"/> ft. after <input type="checkbox"/> hrs. pumping <input type="checkbox"/> g.p.m. <input type="checkbox"/> ft. after <input type="checkbox"/> hrs. pumping <input type="checkbox"/> g.p.m. Estimated maximum yield <input type="checkbox"/> g.p.m.		
Sand and Gravel and Clay Streaks at 36', 39', and 59'			13. Water sample submitted: <u>chl-8080</u> mo./day/yr. <input checked="" type="checkbox"/> Yes <input type="checkbox"/> No Date <u>12/28/77</u>		
Red Shale			14. Well head completion: <input type="checkbox"/> Pitless adapter <input type="checkbox"/> Inches above grade		
			15. Well grouted? <u>No</u> ** With: <input type="checkbox"/> Neat cement <input type="checkbox"/> Bentonite <input type="checkbox"/> Concrete Depth: From <input type="checkbox"/> ft. to <input type="checkbox"/> ft.		
			16. Nearest source of possible contamination: ft. <input type="checkbox"/> Direction <input type="checkbox"/> Type <input type="checkbox"/> Well disinfected upon completion? <input type="checkbox"/> Yes <input checked="" type="checkbox"/> No		
			17. Pump: <input checked="" type="checkbox"/> Not installed Manufacturer's name <input type="checkbox"/> Model number <input type="checkbox"/> HP <input type="checkbox"/> Volts <input type="checkbox"/> Length of drop pipe <input type="checkbox"/> ft. capacity <input type="checkbox"/> g.p.m. Type: <input type="checkbox"/> Submersible <input type="checkbox"/> Turbine <input type="checkbox"/> Jet <input type="checkbox"/> Reciprocating <input type="checkbox"/> Centrifugal <input type="checkbox"/> Other		
(Use a second sheet if needed)					
18. Elevation: (Ground) <u>1644.1</u> Topography: <input type="checkbox"/> Hill <input type="checkbox"/> Slope <input type="checkbox"/> Upland <input type="checkbox"/> Valley		19. Remarks: * Work performed on behalf of Cecil Miller etal to obtain ground water information RE: Miller vs. Cudahay lawsuit. **Test wells were considered temporary when drilled. Due to pending litigation, a decision to plug wells or grout & establish permanent observation wells has not been made.		20. Water well contractor's certification: This well was drilled under my jurisdiction and this report is true to the best of my knowledge and belief. <b>Clarke Well &amp; Equip., Inc. 185</b> Business name <u>Great Bend, KS 67530</u> License No. Address <u>Clarke</u> Date <u>8-25-78</u> Signed <u>Clarke</u> Authorized representative	

20-80-14 SESUWE  
1/4 1/4 03/14