


1 LOCATION OF WATER WELL: Fraction SE 1/4 SE 1/4 SE 1/4 Section Number 16 Township Number T 20 S Range Number R 8 E/W  
 County: Rice  
 Distance and direction from nearest town or city street address of well if located within city?  
2 1/4 South of Lyons, Ks.

2 WATER WELL OWNER: H. C. Taylor  
 RR#, St. Address, Box # : Lyons, Ks. 67554 Board of Agriculture, Division of Water Resources  
 City, State, ZIP Code : Lyons, Ks. 67554 Application Number:

3 LOCATE WELL'S LOCATION WITH AN "X" IN SECTION BOX:

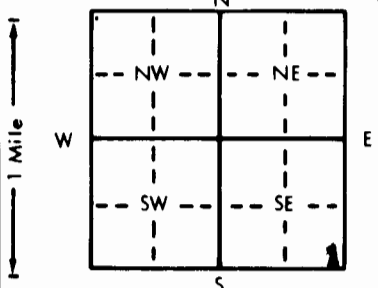

4 DEPTH OF COMPLETED WELL: 60 ft. ELEVATION:

Depth(s) Groundwater Encountered 1. 1 ft. 2. 1 ft. 3. 1 ft.  
 WELL'S STATIC WATER LEVEL 22 ft. below land surface measured on mo/day/yr 8-16-89  
 Pump test data: Well water was NA ft. after NA hours pumping NA gpm  
 Est. Yield NA gpm: Well water was NA ft. after NA hours pumping NA gpm  
 Bore Hole Diameter 10 in. to 60 ft., and NA in. to NA ft.  
 WELL WATER TO BE USED AS: 5 Public water supply 8 Air conditioning 11 Injection well  
 Domestic 3 Feedlot 6 Oil field water supply 9 Dewatering 12 Other (Specify below)  
 Irrigation 4 Industrial 7 Lawn and garden only 10 Monitoring well Live Stock  
 Was a chemical/bacteriological sample submitted to Department? Yes NA No X; If yes, mo/day/yr sample was submitted  
 Water Well Disinfected? Yes hth No

5 TYPE OF BLANK CASING USED: 5 Wrought iron 8 Concrete tile CASING JOINTS: Glued X Clamped  
 1 Steel 3 RMP (SR) 6 Asbestos-Cement 9 Other (specify below) Welded  
2 PVC 4 ABS 7 Fiberglass Threaded

Blank casing diameter 5 in. to 40 ft., Dia NA in. to NA ft., Dia NA in. to NA ft.  
 Casing height above land surface 18 in., weight 258 lbs./ft. Wall thickness or gauge No. NA

TYPE OF SCREEN OR PERFORATION MATERIAL: 7 PVC 10 Asbestos-cement  
 1 Steel 3 Stainless steel 5 Fiberglass 8 RMP (SR) 11 Other (specify)  
 2 Brass 4 Galvanized steel 6 Concrete tile 9 ABS 12 None used (open hole)

SCREEN OR PERFORATION OPENINGS ARE: 5 Gauzed wrapped 8 Saw cut 11 None (open hole)  
 1 Continuous slot 3 Mill slot 6 Wire wrapped 9 Drilled holes  
 2 Louvered shutter 4 Key punched 7 Torch cut 10 Other (specify)

SCREEN-PERFORATED INTERVALS: From 40 ft. to 60 ft., From NA ft. to NA ft., From NA ft. to NA ft.  
 GRAVEL PACK INTERVALS: From 20 ft. to 60 ft., From NA ft. to NA ft., From NA ft. to NA ft.

6 GROUT MATERIAL: 1 Neat cement 2 Cement grout 3 Bentonite 4 Other  
 Grout Intervals: From 0 ft. to 20 ft., From NA ft. to NA ft., From NA ft. to NA ft.

What is the nearest source of possible contamination:  
 1 Septic tank 4 Lateral lines 7 Pit privy 10 Livestock pens 14 Abandoned water well  
 2 Sewer lines 5 Cess pool 8 Sewage lagoon 11 Fuel storage 15 Oil well/Gas well  
 3 Watertight sewer lines 6 Seepage pit 9 Feedyard 12 Fertilizer storage 16 Other (specify below)  
 13 Insecticide storage none

Direction from well? How many feet?

FROM	TO	LITHOLOGIC LOG	FROM	TO	PLUGGING INTERVALS
0	3	Top soil			
3	23	Clay			
23	35	Sand and gravel			
35	38	Clay			
38	60	Sand and gravel			

7 CONTRACTOR'S OR LANDOWNER'S CERTIFICATION: This water well was (1) constructed, (2) reconstructed, or (3) plugged under my jurisdiction and was completed on (mo/day/year) 8-16-89 and this record is true to the best of my knowledge and belief. Kansas Water Well Contractor's License No. 134 This Water Well Record was completed on (mo/day/yr) 11-29-89 under the business name of Rosencrantz Bemis by (signature) Fredia Redson