

USE TYPEWRITER OR BALL POINT PEN-PRESS FIRMLY, PRINT CLEARLY.


T R EW sec 1/4 1/4 1/4 No.

WATER WELL RECORD
KSA 82a-1201-1215

Kansas State Dept. Of Health
(Water Well Contractors)
Forbes-Bldg. 740
Topeka, Kansas 66620

1 Location of well: County Rice Township name Atlanta Fraction NE Section number 31 Town number 20 Range number 8-W

Distance and direction from nearest town or city: 1/2 N Aiden 3/4 East 3 Owner of well: Duane Johnson
Street address of well location if in city: 3/4 N west in field Address: RFD Sterling, Kansas 67579

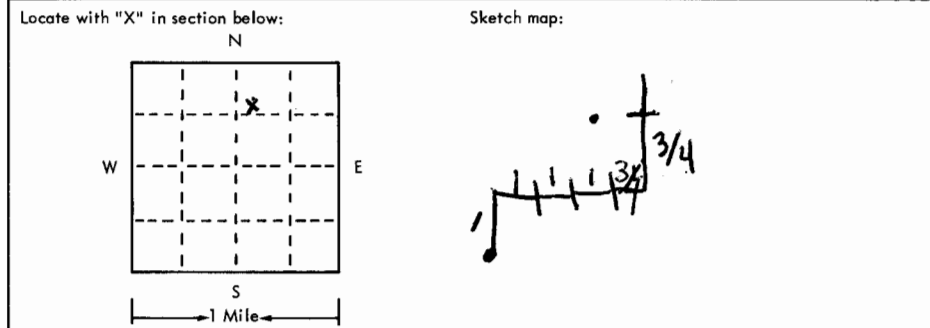

4 Well depth: 68 ft. Date of completion 5/1/78
Well diameter 24 in.

5 Cable tool Rotary Driven Dug
 Hollow rod Jetted Bored Reverse rotary

6 Use: Domestic Public supply Industry
 Irrigation Air conditioning Commercial
 Test well

7 Casing: Material Transite Height: above/below
Threaded Welded Surface 8 in.
Diam. 16 in. to 16 in. Weight 30 lbs./ft.
Drive shoe? Yes No
16 in. to 33 ft. depth

| 2 | Type and color of material | From | To |
|---|--------------------------------|-----------|-----------|
| | <u>Top soil</u> | <u>0</u> | <u>5</u> |
| | <u>Brown sandy Clay</u> | <u>5</u> | <u>15</u> |
| | <u>Fine to Med. Sand</u> | <u>15</u> | <u>20</u> |
| | <u>Med. to coarse sand</u> | <u>20</u> | <u>25</u> |
| | <u>Med. to coarse sand</u> | <u>25</u> | <u>45</u> |
| | <u>Coarse sand</u> | <u>45</u> | <u>50</u> |
| | <u>Sandy clay</u> | <u>50</u> | <u>55</u> |
| | <u>Fine sand</u> | <u>55</u> | <u>60</u> |
| | <u>Fine to Med. sand</u> | <u>60</u> | <u>65</u> |
| | <u>Med. sand</u> | <u>65</u> | <u>67</u> |
| | <u>Brown clay</u> | <u>67</u> | <u>75</u> |
| | (use a second sheet if needed) | | |

8 Screen: Manufacturer Johnson
Type Sawed Dia. 16
Slot/gauze 3/16 Length 39'
Set between 33 ft. and 68 ft.
Fittings:
Gravel pack Yes No Size range of material 1/8 - 1/4

9 Static water level: 22'
22 ft. below land surface Date 5-1-78

10 Pumping level below land surfaces:
45 ft. after 1 hrs. pumping 700 g.p.m.
48 ft. after 2 hrs. pumping 800 g.p.m.
Estimated maximum yield 900 g.p.m.

11 Water sample submitted:
 Yes No Date _____

12 Well head completion:
 Pitless adapter 8" Inches above grade

13 Well grouted? Yes No
 Neat cement Bentonite Cement
Depth: From 0 ft. to 10 ft.

14 Nearest source of possible contamination:
ft. _____ Direction _____ Type _____
Well disinfected upon completion? Yes No

15 Pump: Not installed
Manufacturer's name Western Land Roller
Model number 4530 HP 50 Volts 460
Length of drop pipe 500 ft. capacity 850 g.p.m.
Type:
 Submersible Turbine
 Jet Reciprocating
 Centrifugal Other

16 Remarks: elevation

Topography:
 Hill
 Slope
 Upland
 Valley

17 Water well contractor's certification:
This well was drilled under my jurisdiction and this report is true to the best of my knowledge and belief.
Darling Drilling Co. License No. 189
Business name _____
Address 111 W. 4th, Hutchinson, Kans.
Signed Ronald Darling Date 5-20-79
Authorized representative

T205 R8W Sec 31 NE