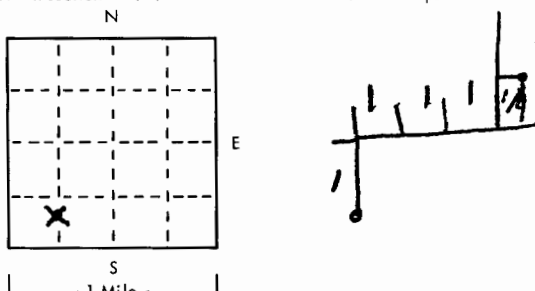


USE TYPEWRITER OR BALL POINT PEN-PRESS FIRMLY, PRINT CLEARLY.

20 8 W 3 1 SW  
T R EW sec 1/4 1/4 1/4 No.

WATER WELL RECORD  
KSA 82a-1201-1215

Kansas State Dept. Of Health  
(Water Well Contractors)  
Forbes-Bldg. 740  
Topeka, Kansas 66620

1 Location of well:	County <b>Rice</b>	Township name <b>Atlanta</b>	Fraction <b>SW</b>	Section number <b>31</b>	Town number <b>20</b>	Range number <b>8</b>
Distance and direction from nearest town or city: <b>1 North Alden 3 East 1/4 N East to Pivot 200' So</b>				3 Owner of well: <b>Don Ray</b> Address: <b>RFD Sterling, Kansas 67579</b>		
Locate with "X" in section below: N W E S 1 Mile		Sketch map: 		4 Well depth: <b>41</b> ft. Date of completion: <b>4/24/78</b> Well diameter <b>28</b> in.		
2				5 <input type="checkbox"/> Cable tool <input type="checkbox"/> Rotary <input type="checkbox"/> Driven <input type="checkbox"/> Dug <input type="checkbox"/> Hollow rod <input type="checkbox"/> Jetted <input type="checkbox"/> Bored <input checked="" type="checkbox"/> Reverse rotary		
				6 Use: <input type="checkbox"/> Domestic <input type="checkbox"/> Public supply <input type="checkbox"/> Industry <input checked="" type="checkbox"/> Irrigation <input type="checkbox"/> Air conditioning <input type="checkbox"/> Commercial <input type="checkbox"/> Test well <input type="checkbox"/>		
Type and color of material				7 Casing: Material <b>transite</b> Weight: above/below Threaded <input type="checkbox"/> Welded <input type="checkbox"/> Surface <b>12</b> in. Diam. Weight <b>30</b> lbs./ft. <b>16</b> in. to <b>0</b> ft. depth Drive shoe? <input type="checkbox"/> Yes <input checked="" type="checkbox"/> No <b>16</b> in. to <b>13</b> ft. depth		
				8 Screen: Manufacturer <b>Johnson</b> Type <b>sawed</b> Dia. <b>16</b> Slot/gauze <b>3/16</b> Length <b>26</b> Set between <b>13</b> ft. and <b>41</b> ft. Fittings: Gravel pack <input checked="" type="checkbox"/> Yes <input type="checkbox"/> No Size range of material <b>1/8 to 1/4</b>		
Top soil				9 Static water level: <b>18</b> ft. below land surface Date <b>4-24-78</b>		
Clay (Little gravel)				10 Pumping level below land surfaces: <b>31</b> ft. after <b>1</b> hrs. pumping <b>400</b> g.p.m. _____ ft. after _____ hrs. pumping _____ g.p.m. Estimated maximum yield <b>400</b> g.p.m.		
Med. gravel				11 Water sample submitted: <input type="checkbox"/> Yes <input checked="" type="checkbox"/> No Date _____		
Small gravel				12 Well head completion: <input type="checkbox"/> Pitless adapter <input checked="" type="checkbox"/> Inches above grade		
Coarse gravel				13 Well grouted? <input checked="" type="checkbox"/> Yes <input type="checkbox"/> No <input type="checkbox"/> Neat cement <input checked="" type="checkbox"/> Bentonite <input checked="" type="checkbox"/> <b>Cement</b> Depth: From <b>0</b> ft. to <b>10</b> ft.		
				14 Nearest source of possible contamination: ft. _____ Direction _____ Type _____ Well disinfected upon completion? <input type="checkbox"/> Yes <input checked="" type="checkbox"/> No		
				15 Pump: <input type="checkbox"/> Not installed Manufacturer's name <b>Western Land Roller</b> Model number <b>6 Star KC</b> HP <b>30</b> Volts <b>460</b> Length of drop pipe <b>30</b> ft. capacity <b>350</b> g.m.p. Type: <input type="checkbox"/> Submersible <input checked="" type="checkbox"/> Turbine <input type="checkbox"/> Jet <input type="checkbox"/> Reciprocating <input type="checkbox"/> Centrifugal <input type="checkbox"/> Other		
16 Remarks: elevation				17 Water well contractor's certification: This well was drilled under my jurisdiction and this report is true to the best of my knowledge and belief. <b>Darling Drilling Co. 189</b> Business name License No. _____ Address <b>211 W. 4th Antchinson, Ks.</b> Signed <b>[Signature]</b> Date <b>5-2-79</b> Authorized representative		