

USE TYPEWRITER OR BALL POINT PEN-PRESS FIRMLY, PRINT CLEARLY.

WATER WELL RECORD
KSA 82a-1201-1215

T	R	EW	sec 1/4 1/4 1/4 No.
---	---	----	---------------------

Kansas State Dept. Of Health
(Water Well Contractors)
Forbes-Bldg. 740
Topeka, Kansas 66620


1 Location of well:	County <u>Rice</u>	Township name <u>atlanta</u>	Fraction <u>S-E 1/4 S-W 1/4</u>	Section number <u>33</u>	Town number <u>20-S</u>	Range number <u>8-W</u>
---------------------	--------------------	------------------------------	---------------------------------	--------------------------	-------------------------	-------------------------

Distance and direction from nearest town or city: 3 miles north of Sterling Kane.

Street address of well location if in city: _____

3 Owner of well: Melrose McCortland

Address: Sterling Kane, north Broadway

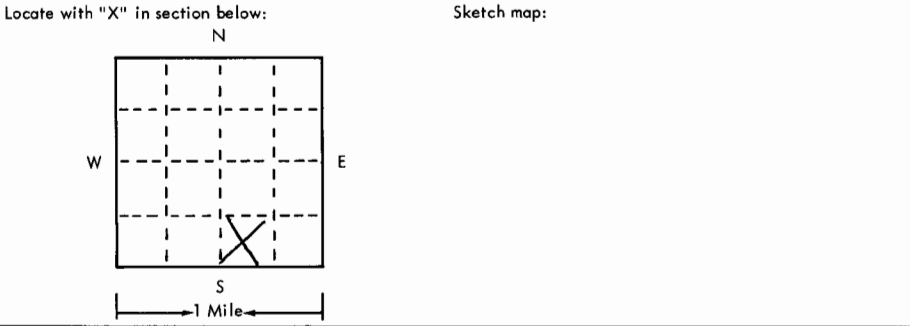

4 Well depth: 45 ft. Date of completion 9-29-75

Well diameter 9 in.

5 Cable tool Rotary Driven Dug
 Hollow rod Jetted Bored Reverse rotary

6 Use: Domestic Public supply Industry
 Irrigation Air conditioning Commercial
 Test well Human - Stock

7 Casing: Material Plast Height: above/below
Threaded Welded Surface 12 in.
Digm. 6 in. to 45 ft. depth! Drive shoe? Yes No
 in. to ft. depth! Weight 4 lbs./ft. L

2	Type and color of material	From	To
	Soil	0	5
	clay	5	20
	Sandy clay	20	30
	gravel	30	45

8 Screen:

Manufacturer certentent

Type PVC plast Dia. 6 in.

Slot/gauze 1/16 Length 15 ft.

Set between 30 ft. and 45 ft.

Fittings:

Gravel pack Yes No Size range of material 1/4

9 Static water level: 15 ft. below land surface Date Sept 29-75

10 Pumping level below land surfaces:

 ft. after hrs. pumping g.p.m.

 ft. after hrs. pumping g.p.m.

Estimated maximum yield 30 g.p.m.

11 Water sample submitted:
 Yes No Date

12 Well head completion:
 Pitless adapter Inches above grade

13 Well grouted? Yes No
 Neat cement Bentonite
Depth: From 0 ft. to 10 ft.

14 Nearest source of possible contamination:
ft. 10 dir. all dir. Type
Well disinfected upon completion? Yes No

15 Pump: Not installed

Manufacturer's name

Model number HP Volts

Length of drop pipe ft. capacity g.m.p.

Type:
 Submersible Turbine
 Jet Reciprocating
 Centrifugal Other

16 Remarks: elevation

Topography:
 Hill
 Slope
 Upland
 Valley

17 Water well contractor's certification:
This well was drilled under my jurisdiction and this report is true to the best of my knowledge and belief.

Business name Arthur Varney License No. 147

Address

Signed Arthur Varney date 9-29-75

Authorized representative 19-75

20 8W 33 SWSE