

USE TYPEWRITER OR BALL POINT PEN-PRESS FIRMLY, PRINT CLEARLY.

T R EW sec 1/4 1/4 1/4 No.

WATER WELL RECORD
KSA 82a-1201-1215


Kansas State Dept. Of Health
(Water Well Contractors)
Forbes-Bldg. 740
Topeka, Kansas 66620

SWNE SW

1 Location of well:	County Rice	Township name Atlanta	Fraction SW 1/4	Section number #35	Town number 20 S	Range number 8 W
---------------------	-----------------------	---------------------------------	---------------------------	------------------------------	----------------------------	----------------------------

Distance and direction from nearest town or city:
Street address of well location if in city: **3 N. 1E. Sterling**

3 Owner of well: **Harold Evans**
Address: **Sterling RR 3 67579**

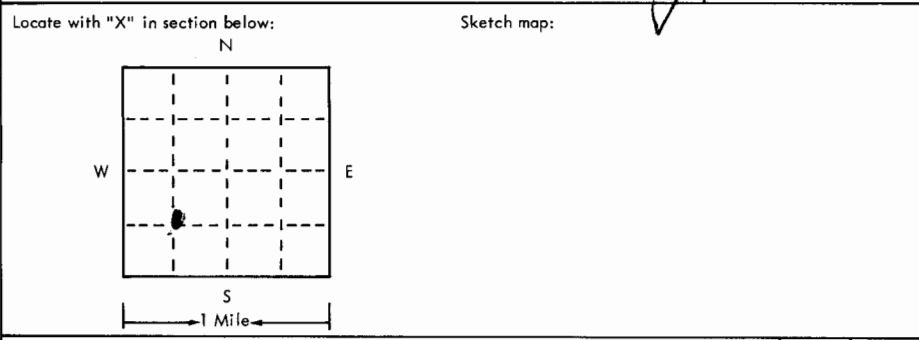

4 Well depth: **91** ft. Date of completion **5/3/75**
Well diameter **28** in.

5 Cable tool Rotary Driven Dug
 Hollow rod Jetted Bored Reverse rotary

6 Use: Domestic Public supply Industry
 Irrigation Air conditioning Commercial
 Test well

7 Casing: Material **galv** Height: above/below **MNC**
Threaded Welded Surface **8** in.
Diam. Weight **30** lbs./ft.
1 1/2 in. to **52** ft. depth Drive shoe? Yes No
___ in. to ___ ft. depth!

2	Type and color of material	From	To
	soil	0	2
	clay	2	10
	sand(fine)	10	25
	gravel(med., clean)	25	88
	shale	88	89

8 Screen: Manufacturer **Johnson**
Type **gauze** Dia. **1 1/2**
Slot/gauze **3/16** Length **39**
Set between **52** ft. and **91** ft.
Fittings: **MNC**
Gravel pack Yes No Size range of material **1/8 to 1/4**

9 Static water level:
18 ft. below land surface Date **1/28/75**

10 Pumping level below land surfaces:
45 ft. after **1** hrs. pumping **1200** g.p.m.
___ ft. after ___ hrs. pumping ___ g.p.m.
Estimated maximum yield **1400** g.p.m.

11 Water sample submitted:
 Yes No Date **1/28/75**

12 Well head completion:
 Pitless adapter Inches above grade

13 Well grouted? Yes No
 Neat cement Bentonite ___
Depth: From **0** ft. to **16** ft.

14 Nearest source of possible contamination:
___ ft. Direction ___ Type ___
Well disinfected upon completion? Yes No

15 Pump: Not installed
Manufacturer's name **Western Land Roller**
Model number **3 BCM 40** Volts **440**
Length of drop pipe **50** ft. capacity ___ g.m.p.
Type:
 Submersible Turbine
 Jet Reciprocating
 Centrifugal Other

16 Remarks: elevation

(use a second sheet if needed)

Topography:
 Hill
 Slope
 Upland
 Valley

17 Water well contractor's certification:
This well was drilled under my jurisdiction and this report is true to the best of my knowledge and belief.
Darling Drilling Co. 189
Business name License No.
Address **1211 W. 17th Hutchinson, Kansas**
Signed **[Signature]** Date **5/3/75**
Authorized representative