


1 LOCATION OF WATER WELL: Fraction NW 1/4 NW 1/4 NE 1/4 Section Number 5 Township Number T 20 S Range Number R 8 EW

Distance and direction from nearest town or city street address of well, if located within city?
2000' west of Lyons, 500' south of Hwy 56

2 WATER WELL OWNER: Rice County Airport
RR#, St. Address, Box #: 460 N. Logan Board of Agriculture, Division of Water Resources
City, State, ZIP Code: Lyons, Ks 67554 Application Number:

3 LOCATE WELL'S LOCATION WITH AN "X" IN SECTION BOX:

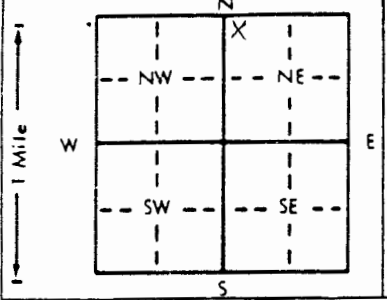

4 DEPTH OF COMPLETED WELL: 42 ft. ELEVATION: 1690 ft.
Depth(s) Groundwater Encountered 1. ft. 2. ft. 3. ft.
WELL'S STATIC WATER LEVEL: 34.1 ft. below land surface measured on mo/day/yr 3/27/95
Pump test data: Well water was ft. after hours pumping gpm
Est. Yield: NA gpm Well water was ft. after hours pumping gpm
Bore Hole Diameter: 8 in. to 42 ft., and in. to ft.
WELL WATER TO BE USED AS:
5 Public water supply 8 Air conditioning 11 Injection well
1 Domestic 3 Feedlot 6 Oil field water supply 9 Dewatering 12 Other (Specify below)
2 Irrigation 4 Industrial 7 Lawn and garden only 10 Monitoring well
Was a chemical/bacteriological sample submitted to Department? Yes No X; If yes, mo/day/yr sample was submitted
Water Well Disinfected? Yes No X

5 TYPE OF BLANK CASING USED:
1 Steel 3 RMP (SR) 5 Wrought iron 8 Concrete tile CASING JOINTS: Glued Clamped
2 PVC 4 ABS 6 Asbestos-Cement 9 Other (specify below) Welded
7 Fiberglass Threaded X
Blank casing diameter: 2 in. to 42 ft., Dia in. to ft., Dia in. to ft.
Casing height above land surface: in., weight lbs. ft. Wall thickness or gauge No. Schedule 40

TYPE OF SCREEN OR PERFORATION MATERIAL:
1 Steel 3 Stainless steel 5 Fiberglass 7 PVC 10 Asbestos-cement
2 Brass 4 Galvanized steel 6 Concrete tile 8 RMP (SR) 11 Other (specify)
9 ABS 12 None used (open hole)
SCREEN OR PERFORATION OPENINGS ARE:
1 Continuous slot 3 Mill slot 5 Gauzed wrapped 8 Saw cut 11 None (open hole)
2 Louvered shutter 4 Key punched 6 Wire wrapped 9 Drilled holes
10 Other (specify)
SCREEN-PERFORATED INTERVALS: From 27 ft. to 42 ft., From ft. to ft.
GRAVEL PACK INTERVALS: From 25 ft. to 42 ft., From ft. to ft.

6 GROUT MATERIAL: 1 Neat cement 2 Cement grout 3 Bentonite 4 Other
Grout Intervals: From 0 ft. to 23 ft., From 23 ft. to 25 ft., From ft. to ft.
What is the nearest source of possible contamination:
1 Septic tank 4 Lateral lines 7 Pit privy 10 Livestock pens 14 Abandoned water well
2 Sewer lines 5 Cess pool 8 Sewage lagoon 11 Fuel storage 15 Oil well/Gas well
3 Watertight sewer lines 6 Seepage pit 9 Feedyard 12 Fertilizer storage 16 Other (specify below) UST
13 Insecticide storage 170
Direction from well? S/SW How many feet? 170

FROM	TO	LITHOLOGIC LOG	FROM	TO	PLUGGING INTERVALS
0	2	Clay, Dark Brown			MW3
2	8	Clay, Medium Brown			GeoCore #III Flush-mount Cover
8	19	Clay, Dark Orange-Brown			KDHE #05080564 Tag # 117731
19	23	Sand, Medium Orange-Brown			
23	30	Clay, Medium Orange-Brown			
30	42	Clay, Medium Orange-Brown			

7 CONTRACTOR'S OR LANDOWNER'S CERTIFICATION: This water well was (1) constructed, (2) reconstructed, or (3) plugged under my jurisdiction and was completed on (mo/day/year) 3/27/95 and this record is true to the best of my knowledge and belief. Kansas Water Well Contractor's License No. 527 This Water Well Record was completed on (mo/day/yr) 4/25/95 under the business name of GeoCore Services, Inc. by (signature) Dale Rohl